

Coahoma
H23
1-67

MISSISSIPPI
BOARD OF WATER COMMISSIONERS
416 North State Street
Jackson, Mississippi 39201

2/15/67
JN

WATER WELL DRILLERS **ANNED** 361

January 22, 1967 Layne-Central Company Coahoma
date well completed firm name county well located

LANDOWNER: J. H. Sherard & Son

description of formations encountered	from	to
Clay	0	18
Fine sand	18	32
Coarse sand	32	55
Coarse sand, pea gravel	55	80
Coarse sand, gravel	80	112

Sherard, Mississippi
(mailing address)

WELL LOCATION:


sec. 22 T. 27 N R. 5 E
23 XX W
miles east of Sherard
(distance) (direction) (nearest town)

WELL PURPOSE: Irrigation
(home, irrigation, municipal, industrial)

WELL COMPLETION DATA:

- (1) diameter (inches) 12"
- (2) total depth (feet) 112'
- (3) static water level (feet) 17' 2" below top of ground.
- (4) casing steel 62' (material), (depth)
12" (size) if telescope see back.
- (5) screen 50' 62' (length), (depth to top)
12" Armco iron (size), (material)
- (6) pump eninge (HP), (yield gpm)
(type power)
- (7) electric log no (yes or no)
(organization running log)
- (8) how well bottom plugged plate

CODED

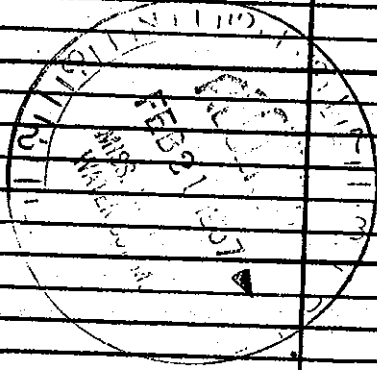

DRILLERS REMARKS: