

COAHOMA MISSISSIPPI BOARD OF WATER COMMISSIONERS

391144090335001

J 80 HAS
5-14-63

WATER WELL DRILLERS LOG **CODED**

Date: 5/14, 1963, Driller: Fine County, Louisiana
(Name)

(1) Owner of Land	Description & Color of Materials Sand, Clay, Red Clay, Shell, etc.	Thick- ness Feet	Depth Feet
<u>Leon Bramlett</u> (Name)	<u>clay</u>	<u>14</u>	<u>14</u>
<u>Clarksdale, Miss</u> (Address)	<u>clay fine sand</u>	<u>13</u>	<u>27</u>
<u>27N SW</u>	<u>clay</u>	<u>10</u>	<u>37</u>
(2) Location: <u>1/4</u> , <u>1/4</u> , Sec <u>24</u> <u>26R40S</u>	<u>fine sand</u>	<u>13</u>	<u>50</u>
<u>4</u> miles <u>west</u> , of <u>Clarksdale</u> (distance) (direction) (Nearest Town)	<u>sand</u>	<u>10</u>	<u>60</u>
(3) Topography: <u>Level</u> (Hilly) (Flat) (Level)	<u>Coarse Sand P. Sand</u>	<u>50</u>	<u>110</u>
(4) Purpose of Well: <u>irrigation</u> (Domestic Irrigation Municipal, Industrial, Other)	<u>Gravel</u>	<u>16</u>	<u>126</u>

Information upon completion of well:

- (1) Diameter 16 inches.
- (2) Total Depth 123 feet.
- (3) Water Level 22 feet below top of ground.
- (4) Cased to 04, Size 16 "
- (5) Screen: Size 16 ", Length 59 "
- (6) Were any formations sealed against pollution?
no yes, no.


If YES depth of formation _____

Why _____

Drillers Remarks: Pump

3250 G.P.M

CODED

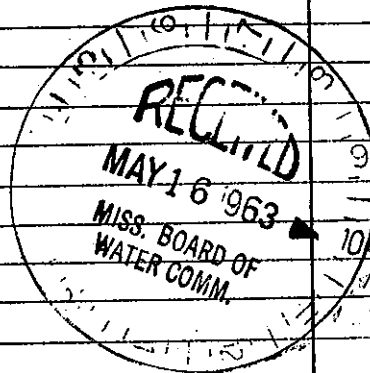

Well No.

(Use Back Side)

Mail this copy to Board of Water Commissioners 429 Miss. St. Jackson, Miss