

COABOMA
H53


MISSISSIPPI
BOARD OF WATER COMMISSIONERS
416 North State Street
Jackson, Mississippi 39201

WATER WELL DRILLERS LOG

1/1/20/87 date well completed Five On Farmer Bros firm name COABOMA county well located

LANDOWNER: <u>OSCAR CONNELL</u>	description of formations encountered	from	to
<u>Sherard Miss</u>	<u>Top soil</u>	<u>0</u>	<u>6</u>
(mailing address)	<u>Clay</u>	<u>6</u>	<u>18</u>
WELL LOCATION:	<u>Fin sand</u>	<u>18</u>	<u>266</u>
sec. <u>21</u> T. <u>270</u> N. R. <u>5</u> E. S. <u>5</u>	<u>Coarse sand & gravel</u>	<u>266</u>	<u>100</u>
<u>1 1/2</u> miles <u>SOUTH</u> of <u>Sherard</u>			
(distance) (direction) (nearest town)			
WELL PURPOSE: (home, irrigation, municipal, industrial)			
WELL COMPLETION DATA:			
(1) diameter (inches) <u>12"</u>			
(2) total depth (feet) <u>100'</u>			
(3) static water level (feet) _____ below/above top of ground.			
(4) casing <u>Steel</u> , <u>60'</u> (material) (depth)			
<u>12"</u> (size) if telescope see back.			
(5) screen <u>40'</u> , <u>60'</u> (length) (depth to top)			
<u>12"</u> , <u>Steel</u> (size) (material)			
(6) pump <u>40</u> (HP) <u>700</u> (yield gpm)			
<u>diesel</u> (type power)			
(7) electric log <u>no</u> (yes or no)			
(organization running log)			
(8) how well bottom plugged <u>well</u>			
DRILLERS REMARKS: <u>08108 - CMC-020388</u>			

08108 - CMC-020388

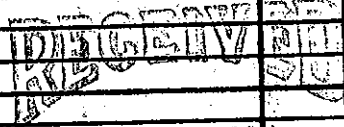

JAN 12 1987

Department of Natural Resources
Bureau of Land & Water Resources