

County: Coahoma
Permit #: GW-45568 ✓
Driller: Irrigation Equipment
Date drilling completed: 03/01/2012

State Well Report
Part 1 – Driller's Log
Mississippi Department of Environmental Quality
Office of Land and Water Resources
P.O. Box 2309
Jackson, MS 39225
(601) 961-5210
(601) 961-5228 (fax)

For Office Use Only:
Aquifer: H109
Well #: _____
L.S. Elevation: _____
E-log #: _____

State Law requires that this report be prepared by the license holder responsible for the work and filed with the Department at the above address within 30 days of completion of drilling of the well or borehole.

| Information on Well Owner (Landowner if borehole is not for a water well) | Well or Borehole Location |
|--|--|
| Owner Name: <u>Connell Family LLC</u> | Latitude: <u>34 ° 08 ' 56 "</u> Longitude: <u>90 ° 42 ' 27 "</u> |
| Mailing Address: <u>P.O. Box 790</u> | Method of Lat/Long (check one): <input type="checkbox"/> Conventional Survey, |
| <u>Clarksdale</u> <u>Ms</u> <u>38614</u> | <input type="checkbox"/> USGS quad, <input checked="" type="checkbox"/> Hand-held GPS, <input type="checkbox"/> Survey-grade GPS |
| City State Zip code | <u>SE</u> ¼ <u>SW</u> ¼ Sec <u>3</u> ✓ Twn <u>26N</u> Rng <u>5W</u> |
| Telephone No. () - | Distance Direction Nearest Town |
| | <u>3</u> Miles <u>North</u> of <u>Alligator</u> |

Well / Borehole Data

Date drilling started: 03/01/2012 Date drilling completed: 03/01/2012 Hole depth: 101 Hole diameter: 24"

Location of the source of any surface water used for drilling: Surface Water

Method of dosing and volume of Chlorine used in drilling and development: 50 PPM

Logs run (check all applicable): No log run Electric Gamma Ray Density Sonic Neutron Other: _____

Name of organization running log(s): _____

Purpose of borehole (check one): Water Well Geotechnical/Geological Investigation Ground Source Heat Pump

Seismic Survey Other (describe) _____

If drilling is not related to water well construction, skip the remainder of this block

Purpose of Well (check one) Home Industrial Public Supply Irrigation Fish Culture Other: _____

If flowing, method of flow regulation: Valve _____ Other (describe) _____

Static Water Level: 22 feet above or below (check one) land surface Date measured: 03/02/2012

Method of Measurement (check one) steel tape electric tape air line other: _____

Well depth: 101 Well grouted to a depth of 10 feet Type of grout (check one): Neat Cement Bentonite Mix

Casing length: 61 feet Casing diameter: 16 inches Type of casing: PVC

Screen length: 40 feet Screen diameter: 16 inches Type of screen: PVC

Screen slot size: .050 inches Setting depth: From 62 feet to 101 feet

Type of completion (check all applicable): Gravel packed Underreamed Telescoped Open hole Natural Development

Other (describe): _____

Top of lap pipe or reduction in casing: _____ feet. **If telescoped or more than one screen, describe on next page**

Form: OLWR-SWR-1A (04/08)

RECEIVED
MAR 27 2012
BY: OLWR

H109

The sketch below only required for water wells

If well telescopes, show depths on sketch.

Description of formations encountered must be provided for all wells and boreholes, unless specifically exempted by regulations

Ground level _____

| Description of Formations Encountered | From (depth) | To (depth) |
|---------------------------------------|--------------|------------|
| Clay | Ground level | 38 |
| Fine Sand | 39 | 49 |
| Fine Sand & Gravel | 50 | 54 |
| Medium Sand & Gravel | 55 | 98 |
| Clay | 99 | 101 |
| | | |
| | | |
If more than one screen, show location of each on sketch

Sketch the property layout and include the following: 1) the well location; 2) any permanent structures on the property that may aid in locating the well; 3) any roads, power lines, or other items that may aid in locating the property and the well; 4) a north arrow.

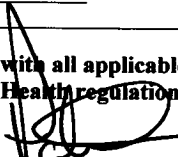
Landowner Name: Connell Family LLC

Form: OLWR-SWR-1A (04/08)

I certify that the well/borehole was drilled, constructed, and completed in accordance with all applicable requirements of the Mississippi Department of Environmental Quality and the Mississippi Department of Health regulations, if applicable, and state laws.

Patrick Chism/Irrigation Equipment 0695
Print Name of Responsible Licensee and License No.

03/22/2012
Date


Signature of Licensee

RECEIVED

MAR 27 2012

BY: OLWR

STATE WELL REPORT

Part 2

Pump Installer's Completion Report

Mississippi Department of Environmental Quality
Office of Land and Water Resources
P.O. Box 2309
Jackson, MS 39225
(601) 961-5210
(601) 961-5228 (fax)

For Office Use Only:

Aquifer: _____
Well #: H109
Elevation: _____

County: Coahoma
Permit #: GW-45568
Driller: Irrigation Equipment
Date drilling completed: 03/01/2012
Copy information from block on Part 1

This part of the report must be completed by a licensed water well contractor or a licensed pump installer. A copy of Part 1 of the report must be attached and both parts filed with the Department at the above address within 30 days of well completion.

| Well Owner Information | Well Location |
|--|--|
| Owner Name: <u>Connell Family LLC</u> | Latitude: <u>34 08' 56 N</u> Longitude: <u>90 42' 27 W</u> |
| Mailing Address: <u>P.O. Box 790</u> | Method of Lat/Long (check one): <input type="checkbox"/> Conventional Survey, |
| <u>Clarksdale</u> <u>Ms</u> <u>38614</u> | <input type="checkbox"/> USGS quad, <input checked="" type="checkbox"/> Hand-held GPS, <input type="checkbox"/> Survey-grade GPS |
| City State Zip code | <u>SE</u> $\frac{1}{4}$ <u>SW</u> $\frac{1}{4}$ Sec <u>3</u> T <u>26N</u> R <u>5W</u> |
| Telephone No. () - | Distance Direction Nearest Town |
| | <u>3</u> Miles <u>North</u> of <u>Alligator</u> |

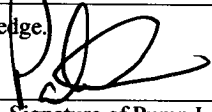
| Pump Type Check one | Power Type Check one |
|---|---|
| <input type="checkbox"/> Air Lift <input type="checkbox"/> Jet <input type="checkbox"/> Submersible | <input checked="" type="checkbox"/> Diesel Engine <input type="checkbox"/> Gasoline Engine <input type="checkbox"/> Natural Gas |
| <input type="checkbox"/> Bucket <input type="checkbox"/> Piston <input checked="" type="checkbox"/> Turbine | <input type="checkbox"/> Electric Motor <input type="checkbox"/> Hand <input type="checkbox"/> Tractor PTO |
| <input type="checkbox"/> Centrifugal <input type="checkbox"/> Rotary <input type="checkbox"/> Flowing Well | <input type="checkbox"/> Windmill <input type="checkbox"/> Other (specify): _____ |
| Other (specify): _____ | Horse Power Rating of Motor: <u>40</u> |
| Date Pump Installed: <u>03/02/2012</u> | Setting Depth: <u>70</u> feet |
| Rated Pump Capacity <u>1600+/-</u> Gallons Per Minute | Number of Stages: <u>2</u> |

| Pump Test Data | Method of Measuring Water Level Check one |
|--|--|
| Date Well Tested: _____ | <input type="checkbox"/> Air Line <input type="checkbox"/> Electric Measuring Line <input type="checkbox"/> Steel Tape |
| Static Water Level (A): _____ Feet Below Land Surface | Other (specify): _____ |
| Pumping Water Level (B): _____ Feet Below Land Surface | For flowing well, measured shut in head: _____ feet |
| Drawdown [(B) - (A)]: _____ Feet Below Land Surface | Well yielded _____ GPM with a drawdown of _____ feet after _____ hours of pumping |
| Test Pumping Rate: _____ Gallons Per Minute | |
| Duration of Pump Test (minimum 4 hours): _____ hours | |

This is for (check one): New Well Replacement of Existing Pump Repair of Existing Pump

I HEREBY CERTIFY that the above statements are true to the best of my knowledge.

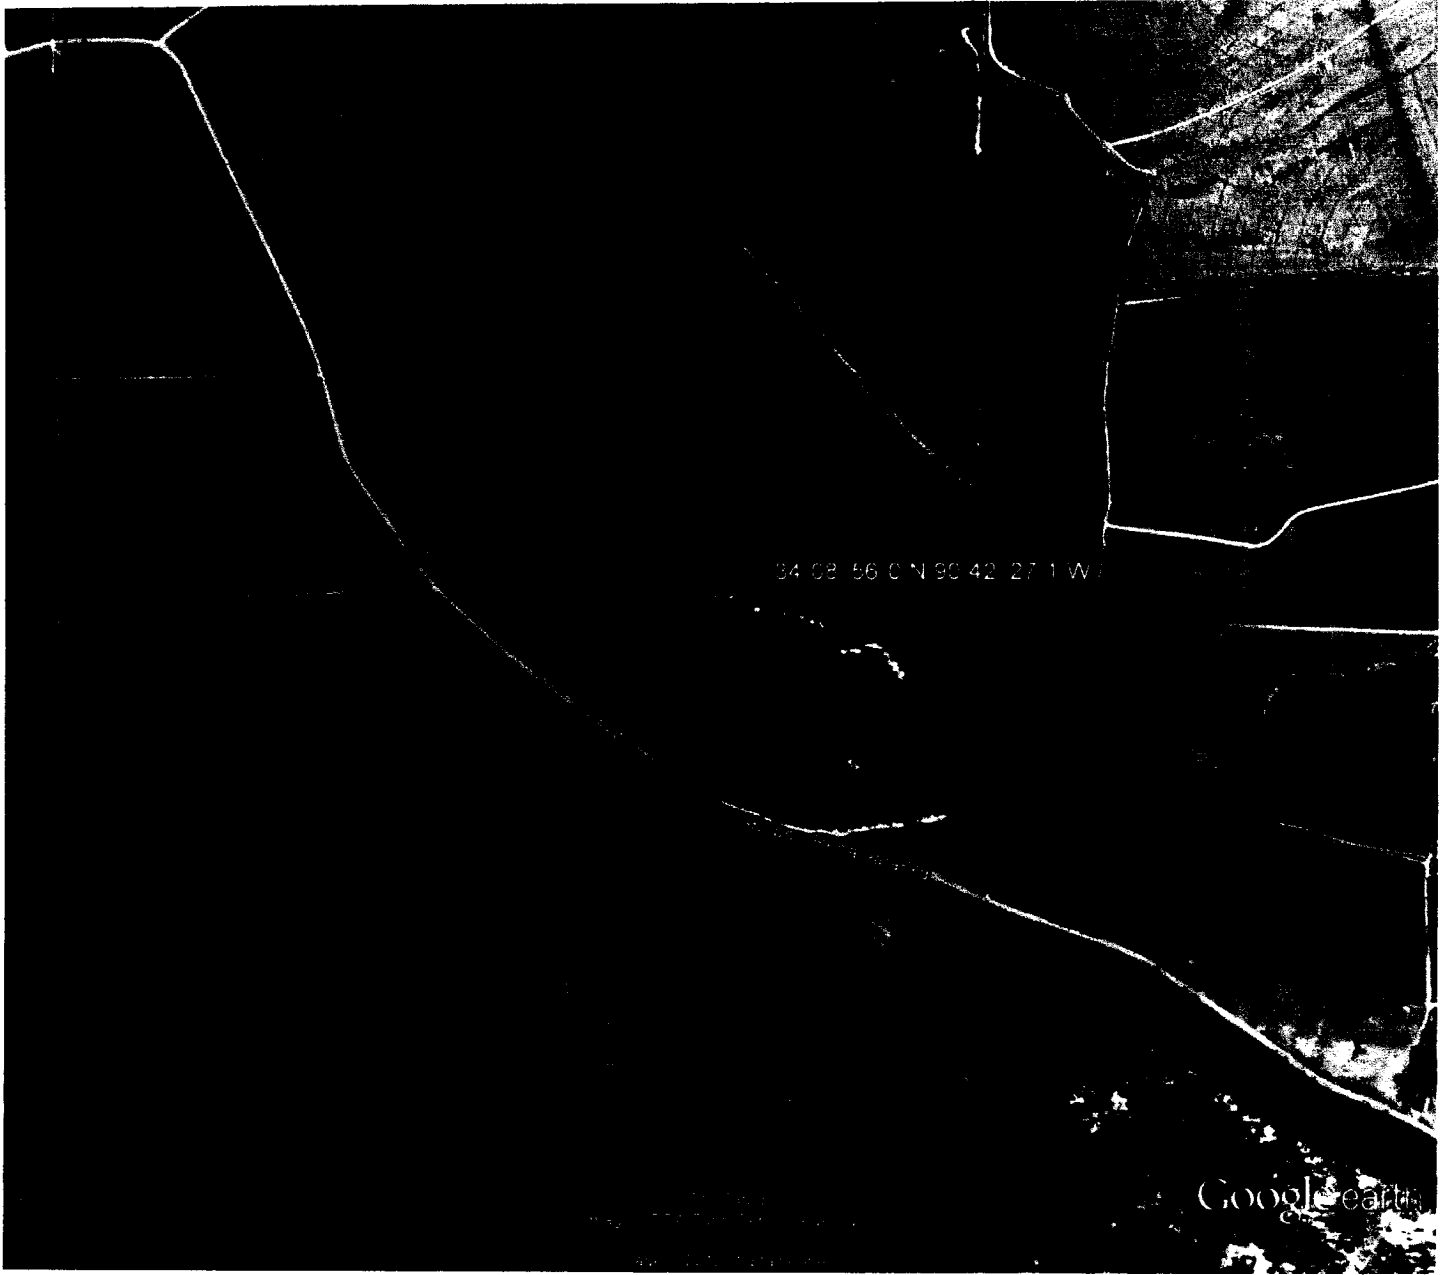
Patrick Chism/Irrigation Equipment 0695
Print Name of Pump Installer and License No. (if applicable)


Signature of Pump Installer

RECEIVED
MAR 27 2012
BY: OLWR

Form: OLWR-SWR-16 (07-09)

H109



Google earth

feet
km



RECEIVED

MAR 27 2012

BY: OLWr