

COAHOMA

MISSISSIPPI BOARD OF WATER COMMISSIONERS Elev. 170

J23

GW 4964

2-25-63

WATER WELL DRILLERS LOG

CODED

Date: 2-25, 1963, Driller: Layne-Central Co. Coahoma

(Name) well #6

(1) Owner of Land:	Description & Color of Materials Sand, Clay, Red Clay, Shell, etc.	Thick- ness Feet	Depth Feet
<u>City of</u> (on back) <u>Clarksdale, Miss.</u>	<u>clay</u>	<u>0-31</u>	
(2) Location: <u>SW 1/4, NE 1/4, Sec 25, T27N, R9W</u>	<u>Sand & clay</u>	<u>31-40</u>	
_____ miles _____ of _____	<u>Sand</u>	<u>40-50</u>	
(3) Topography: _____	<u>Sand & Gravel</u>	<u>50-109</u>	
(4) Purpose of Well: <u>Municipal</u>	<u>Rock, sand &</u>		
_____ (Hilly) _____ (Flat) _____ (Level)	<u>Gravel</u>	<u>109-124</u>	
_____ (distance) _____ (direction) _____ (Nearest Town)	<u>Sand & gravel</u>	<u>124-137</u>	
(4) Purpose of Well: _____	<u>rock</u>	<u>137-141</u>	
_____ (Domestic Irrigation) _____ (Municipal, Industrial, Other)	<u>Sand-Gravel</u>	<u>141-143</u>	
_____	<u>clay</u>	<u>143-153</u>	

Information upon completion of well:


- (1) Diameter 3 1/2 inches.
- (2) Total Depth 148 feet.
- (3) Water Level 28 feet below top of ground.
- (4) Cased to 89', Size 26"
- (5) Screen: Size 1 1/2", Length 50'
- (6) Were any formations sealed against pollution?
 yes, _____ no.

If YES depth of formation 89'

Why Required

Drillers Remarks:

CODED

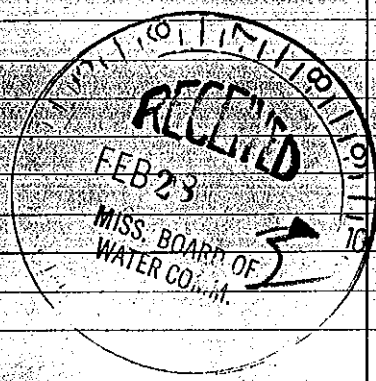

(Use Back Side)

Well No.

Mail this copy to Board of Water Commissioners 429 Miss. St. Jackson, Miss.