

COAHOMA

MISSISSIPPI BOARD OF WATER COMMISSIONERS

J 24

60 4963

Elev. 170

2-25-63

WATER WELL DRILLERS LOG

CODED

Date: 2-25-1963, Driller: Layne Central County Coahoma

(Name)

well # 4

(1) Owner of Land:	Description & Color of Materials Sand, Clay, Red Clay, Shell, etc.	Thick- ness Feet	Depth Feet
<u>City of</u> (Name) <u>Clarksdale, Miss.</u> (Address)	<u>Clay</u> 0-25		
(2) Location: <u>SW 1/4, NE 1/4, Sec. 25 T27N R 4W</u> _____ miles _____, of _____ (distance) (direction) (Nearest Town)	<u>Sand + gravel</u> 25-112		
(3) Topography: _____ (Hilly) (Flat) (Level)	<u>Rocky Sand</u> 112-126		
(4) Purpose of Well: <u>Municipal</u> (Domestic Irrigation Municipal, Industrial, Other)	<u>Sand + gravel</u> 126-148		
	<u>clay</u> 148-216		
	<u>Fine sand-clay</u> 216-232		
	<u>Fine Sand</u> 232-252		
	<u>Sand</u> 252-290		
	<u>Clay</u> 290-302		

Information upon completion of well:


- (1) Diameter 36 inches.
- (2) Total Depth 293 feet.
- (3) Water Level 30' feet below top of ground.
- (4) Cased to 234', Size 26"
- (5) Screen: Size 16", Length 50'
- (6) Were any formations sealed against pollution?
 yes, _____ no.

If YES depth of formation 234'

Why Required

Drillers Remarks:

CODED

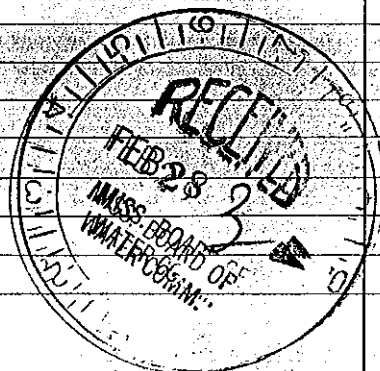

(Use Back Side)

Well No.

Mail this copy to Board of Water Commissioners 429 Miss. St. Jackson, Miss.