

COAHOMA
 J 25
 2-25-63

MISSISSIPPI BOARD OF WATER COMMISSIONERS

GW 4965 Elev. 170
 WATER WELL DRILLERS LOG

CODED

Date: 2-25-1963, Driller: Layne-Central Co. County Coahoma

(Name) well #5

(1) Owner of Land:	Description & Color of Materials Sand, Clay, Red Clay, Shell, etc.	Thick- ness Feet	Depth Feet
City of (Name) Clarksdale, Miss. (Address)	Clay	0-26	
(2) Location: SW 1/4, NE 1/4, Sec. 25 T22R9E	Sand	26-48	
_____ miles _____ of _____ (distance) (direction) (Nearest Town)	Sand + gravel	48-106	
(3) Topography: _____ (Hilly) (Flat) (Level)	Rock	106-111	
(4) Purpose of Well: Municipal (Domestic Irrigation Municipal, Industrial, Other)	Sand + gravel	111-115	
	Rock, Sand		
	+ gravel	115-124	
	Sand Gravel	124-143	
	Clay	143-153	


Information upon completion of well:

- (1) Diameter 36 inches.
- (2) Total Depth 146 feet.
- (3) Water Level 28' feet below top of ground.
- (4) Cased to 86', Size 26"
- (5) Screen: Size 16", Length 50'
- (6) Were any formations sealed against pollution?
 yes, no.

If YES depth of formation:
 Why Required

Drillers Remarks:

CODED

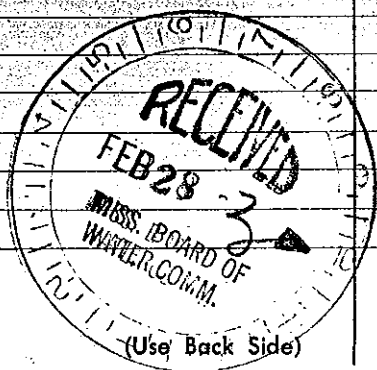

Well No.