


Coded

Coahoma
5-67

MISSISSIPPI
BOARD OF WATER COMMISSIONERS
416 North State Street
Jackson, Mississippi 39201

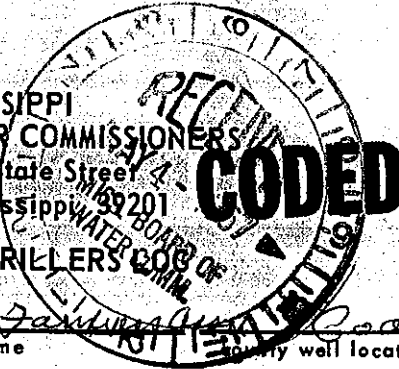

32 WATER WELL DRILLERS CO. OF MISSISSIPPI
date well completed 5-2 firm name J. W. Cant family well located Coahoma

LANDOWNER: Crystal Ice Co
Charlottesville Miss
(mailing address)

| description of formations encountered | from | to |
|---------------------------------------|---------|---------|
| Top Soil + Fine Sand | 0 | 14 |
| Fine Sand | 14 | 20 1/2 |
| Clay | 20 1/2 | 40 |
| Fine Sand | 40 | 46 1/2 |
| Coarse Sand | 46 1/2 | 57 1/2 |
| Coarse Sand + Gravel | 57 1/2 | 102 |
| Clay | 102 | 105 |
| Sand + Gravel | 105 | 128 1/2 |
| Solid Rock at | 128 1/2 | |

WELL LOCATION:
sec 24 T 27 N R 4 W
9 1/2 miles S of Charlottesville
(distance) (direction) (nearest town)

WELL PURPOSE: Industrial
(home, irrigation, municipal, industrial)

WELL COMPLETION DATA:

(1) diameter (inches) 8"

(2) total depth (feet) 125'

(3) static water level (feet) 41' below top of ground

(4) casing 8" Pipe, 105'
(material) (depth)
8" (size) if telescope see back.

(5) screen 20' 57' 105'
(length) (depth to top)
8" Open Mesh
(size) (material)

(6) pump 10 HP 300 (yield gpm)
Eliex
(type power)

(7) electric log No
(yes or no)

(organization running log)

(8) how well bottom plugged welded

Coded

DRILLERS REMARKS: