

Coahoma

MISSISSIPPI BOARD OF WATER COMMISSIONERS

CODI

T 33

NW/4NW, Sec. 24

#9

Elev. 170

Central Fire St

1-66

T 27N, R 4W

WATER WELL DRILLERS LOG

De Soto


Between 213rd

Date: 1-3-1966, Driller: Layne-Central Co. County Coahoma

(Name)

(1) Owner of Land: City of Clarksdale (Name)	Description & Color of Materials Sand, Clay, Red Clay, Shell, etc.	Thick- ness Feet	Depth Feet
Clarksdale, Mississippi (Address)	clay	0-40	745'
(2) Location: NW 1/4, NW 1/4, Sec. 24, T 27N, R 4W	sand-gravel	40-146	
miles _____ of _____ (distance) (direction) (Nearest Town)	rock	146-147	
(3) Topography: _____ (Hilly) (Flat) (Level)	clay	147-190	
(4) Purpose of Well: Municipal (Domestic Irrigation, Municipal, Industrial, Other)	fine sand-clay	190-280	
Information upon completion of well:	sand	280-350	
(1) Diameter: 18 inches.	clay-sand st.	350-407	
(2) Total Depth: 745 feet.	hard clay	407-475	
(3) Water Level: 63' feet below top of ground.	clay-sand st	475-500	
(4) Cased to: 624', Size: 18"	hard clay	500-585	
(5) Screen: Size: 12", Length: 80'	rock	536-537	
(6) Were any formations sealed against pollution? X yes, _____ no.	hard clay	532-621	
If YES depth of formation: 624'	sand-clay	621-627	
Why: _____ required	sand	627-654	
Drillers Remarks: 1000 gpm	gumbo	654-681	
	sand	681-706	
	clay-sand st.	706-717	
	sand	717-725	
	sand-clay	725-741	
	clay	741-757	
	rock	757-759	

CODI

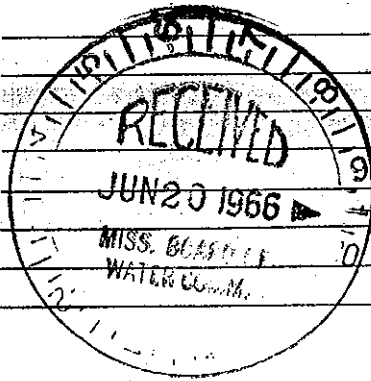

(Use Back Side)

Well No.

Mail this copy to Board of Water Commissioners 429 Miss. St. Jackson, Miss.