

COAHOMA MISSISSIPPI BOARD OF WATER COMMISSIONERS

J 34
10-7-63

WATER WELL DRILLERS LOG

Date: 10/7, 1963, Driller: Bailey Drilling Co County: Washington
(Name)

(1) Owner of Land: Ben Catalina
(Name)
Clarksdale, Miss.
(Address) 3 26 4

(2) Location: 1/4, 1/4, Sec 32 23 31 27 R 4,
3 miles SW of Clarksdale
(distance) (direction) (Nearest Town)

(3) Topography: Flat
(Hilly) (Flat) (Level)

(4) Purpose of Well: Domestic
(Domestic Irrigation
Municipal, Industrial, Other)

Description & Color of Materials Sand, Clay, Red Clay, Shell, etc.	Thick- ness Feet	Depth Feet
Clay		10
Sand		80
Gravel		187
Sand + Mud		230
Rock		231
Sand + Mud		521
Mud		779
Rocks		795
Mud		808
Rock		809
Mud		894
Rocks		907
Mud		1121
Sand + Mud		1165
Mud		1194
Sand		1213
Mud		1396
Sand		1440

Information upon completion of well:

(1) Diameter 4 X 2 1/2 inches.

(2) Total Depth 1440 feet.

(3) Water Level 4 feet above below top of ground.

(4) Cased to all way, Size 4 X 2 1/2.


(5) Screen: Size 2 1/2, Length 30 ft.

(6) Were any formations sealed against pollution?
yes, no,

If YES depth of formation _____

Why _____

Drillers Remarks: _____

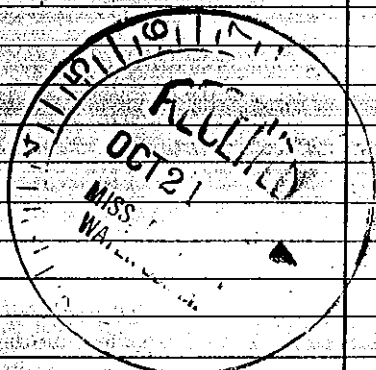

Well No.

(Use Back Side)

Mail this copy to Board of Water Commissioners 429 Miss. St. Jackson, Miss