

COAHOMA MISSISSIPPI BOARD OF WATER COMMISSIONERS

J 581
10-25-60

well J 581

WATER WELL DRILLERS LOG

CODED


Date: 10/25, 1960, Driller: Fine County, Coahoma

(1) Owner of Land: Fine County, Miss.
(Name)
Clarksdale, Miss.
(Address)
(2) Location: 1/4 Sec 25, T. 4 N., R. 20 E.
1/4 miles South of Clarksdale
(Distance) (direction) (Nearest Town)
(3) Topography: Flat
(Hilly) (Flat) (Level)
(4) Purpose of Well: Industrial
(Domestic Irrigation, Municipal, Industrial, Other)

Description	Color of Materials	Thick-ness Feet	Depth Feet
clay		60	60
clay & sand		20	80
Sand & P. kernel		30	110

Information upon completion of well:

(1) Diameter: 8 inches
(2) Total Depth: 110 feet
(3) Water Level: 30 feet below top of ground
(4) Cased to: 80 Size 8"
(5) Screen: Size 6" Length 30'
(6) Were any formations sealed against pollution?
yes, no,

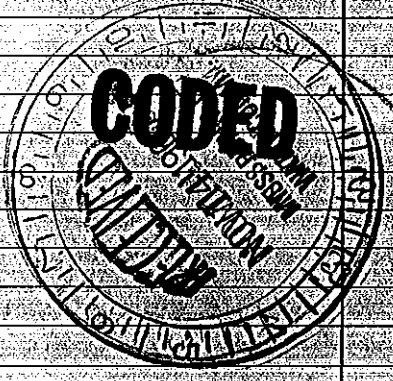

If YES depth of formation:
Why:

Drillers Remarks: Well used to cool condensers using 6" turbine pumping 300 g.p.m.

Well No.

(Use Back Side)