


J 71  
10-1-62

WATER WELL DRILLERS LOG

F  
Coahoma  
Washington

Date: 10/1 1962 Driller: Bailey Drilling Co. County: Washington

(1) Owner of Land:	Description & Color of Materials Sand, Clay, Red Clay Shell, etc.	Thick- ness Feet	Depth Feet
Paul Clark (Name) Clarksdale (Address) 3, 4 27 1	Clay		20
(2) Location: 1/4, 1/4, Sec. 33, 34 T28R4	Gravel		40
4 miles NW of Clarksdale (distance) (direction) (Nearest Town)	Sand		85
(3) Topography: Flat (Hilly) (Flat) (Level)	Gravel		225
(4) Purpose of Well: Domestic (Domestic Irrigation Municipal, Industrial, Other)	Mud		297
Information upon completion of well:	Sand		330
(1) Diameter: 4x3x2 inches	Mud		337
(2) Total Depth: 1235 feet	Sand		560
(3) Water Level: 8 feet below top of ground	Mud		761
(4) Cased to: All way Size 4x3x2	Mud & rocks		794
(5) Screen: Size 2 Length 30ft	Sand		1040
(6) Were any formations sealed against pollution? yes, <input checked="" type="checkbox"/> no.	Mud		1130
If YES depth of formation	Sand		1160
Why	Mud		1166
Drillers Remarks:	Sand		1170
	Mud & Sand		1176
	Sand		1235

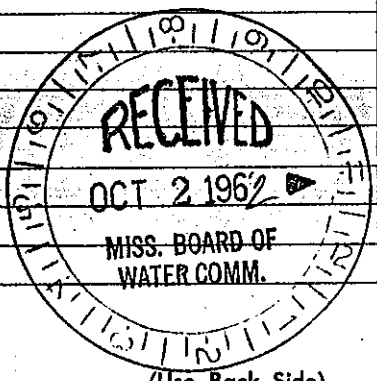

Well No.