

COAHONA MISSISSIPPI BOARD OF WATER COMMISSIONERS

J 73

5-21-64

WATER WELL DRILLERS LOG

CODED

Date: 5-21, 1964, Driller: Five County Farmers County Coahoma

(Name) Assn

(1) Owner of Land: Leon BRAMLETT
 (Name)
Clarksdale Miss
 (Address)

(2) Location: 1/4, 1/4, Sec. 32 27 R 4
1/4 miles West of Kilgus 61
 (direction) (Nearest Town)

(3) Topography: Great
 (Hilly) (Flat) (Level)

(4) Purpose of Well: Irrigation
 (Domestic Irrigation, Municipal, Industrial, Other)

Description & Color of Materials Sand, Clay, Red Clay, Shell, etc.	Thick- ness Feet	Depth Feet
<u>Quicksat</u>	<u>21</u>	<u>0-21</u>
<u>Sand</u>	<u>6 1/2</u>	<u>27 1/2</u>
<u>Coarse Sand</u>	<u>32 1/2</u>	<u>60</u>
<u>Coarse Sand and</u>		
<u>Gravel Large & Small</u>	<u>34</u>	<u>94</u>

Information upon completion of well:

(1) Diameter 1 1/2 inches.


(2) Total Depth 94 feet.

(3) Water Level 20 1/2 feet below top of ground.

(4) Cased to 56 Size 14

(5) Screen: Size 14 Length 48

(6) Were any formations sealed against pollution?
 _____ yes, _____ no.

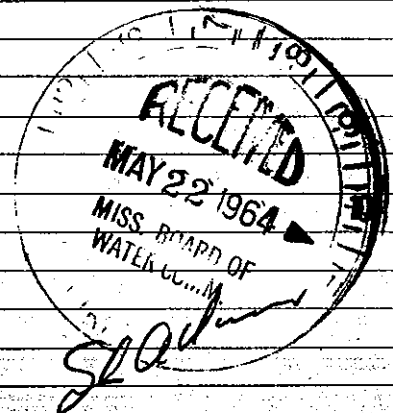

CODED

12" - 28" Stage F.H.H.

If YES depth of formation _____

Why _____

Drillers Remarks: _____

(Use Back Side)

Well No.

Mail this copy to Board of Water Commissioners 429 Miss. St. Jackson, Miss.