

COAHOMA MISSISSIPPI BOARD OF WATER COMMISSIONERS

J 74 #1
3-16-62

WATER WELL DRILLERS LOG

CODED

Date: 3/16, 1962, Driller: Fine County Farm county
(Name)

(1) Owner of Land:	Description & Color of Materials Sand, Clay, Red Clay, Shell, etc.	Thick- ness Feet	Depth Feet
Lion Bromlett (Name) Clarksdale, Miss (Address)	Clay Fine Sand Coarse Sand	30' 15'	30' 45'
(2) Location: 1/4, 1/4, Sec 29 R2RA 1 miles South of Clarksdale (distance) (direction) (Nearest Town)	Sea Level	47	92'
(3) Topography: <input checked="" type="checkbox"/> Level (Hilly) (Flat) (Level)			
(4) Purpose of Well: irrigation (Domestic Irrigation Municipal, Industrial, Other)			

Information upon completion of well:

- (1) Diameter 6 inches.
- (2) Total Depth 92 feet.
- (3) Water Level 20 feet below top of ground.
- (4) Cased to 40, Size 6"
- (5) Screen: Size 6", Length 52'
- (6) Were any formations sealed against pollution?
no.


If YES depth of formation _____

Why _____

Drillers Remarks: _____

1000 g.p.m

CODED

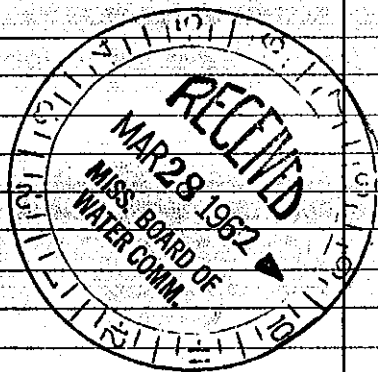

(Use Back Side)

Well No.

Mail this copy to Board of Water Commissioners 429 Miss. St. Jackson, Miss