

COAHOMA MISSISSIPPI BOARD OF WATER COMMISSIONERS

J 75  
3-19-62 #2 WATER WELL DRILLERS LOG

**CODED**

Date: 3/19, 1962 Driller: Fine County, James county, Coahoma  
(Name)

(1) Owner of Land	Description & Color of Materials Sand, Clay, Red Clay, Shell, etc.	Thick- ness Feet	Depth Feet
<u>Leon Burnett</u> (Name)	<u>clay 37'</u>	<u>37</u>	<u>37</u>
<u>Clarksdale, Miss</u> (Address)	<u>fine sand</u>	<u>6</u>	<u>43</u>
(2) Location: <u>1/4</u> , <u>1/4</u> , Sec. <u>28 26</u>	<u>course sand</u>		
<u>1</u> miles <u>South</u> , of <u>Clarksdale</u> (distance) (direction) (Nearest Town)	<u>red gravel</u>	<u>54</u>	<u>97</u>
(3) Topography: <input checked="" type="checkbox"/> (Level)			
(4) Purpose of Well: <u>irrigation</u> (Domestic Irrigation, Municipal, Industrial, Other)			

Information upon completion of well:

(1) Diameter 6 inches.

(2) Total Depth 97 feet.


(3) Water Level 20 feet below top of ground.

(4) Cased to 40, Size 6"

(5) Screen: Size 6", Length 57

(6) Were any formations sealed against pollution?  
\_\_\_\_\_ yes, \_\_\_\_\_ no.

**CODED**

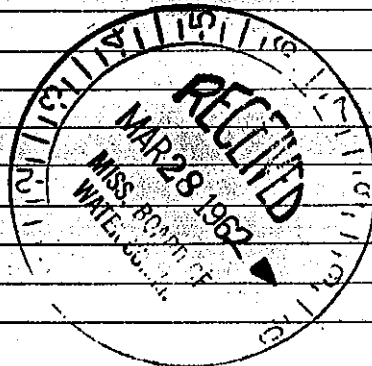

If YES depth of formation \_\_\_\_\_

Why \_\_\_\_\_

Drillers Remarks:  
1580 G.P. M

Well No.

(Use Back Side)

Mail this copy to Board of Water Commissioners 429 Miss. St. Jackson, Miss.