

COAHOMA

MISSISSIPPI BOARD OF WATER COMMISSIONERS

J-81

8-26-65

WATER WELL DRILLERS LOG

CODED 51


Date: Aug. 26, 1965, Driller: Layne-Central Company Coahoma

(Name)

	Description & Color of Materials Sand, Clay, Red Clay, Shell, etc.	Thick- ness Feet	Depth Feet
(1) Owner of Land: <u>Clarksdale Golf Assn.</u> (Name) <u>Clarksdale, Mississippi</u> (Address)	Clay	12	12
(2) Location: <u>1/4, 1/4, Sec. 33 T. 27N. R. 14W.</u>	Fine sand	23	35
_____ miles _____ of <u>Clarksdale</u> (distance) (direction) (Nearest Town)	Coarse sand	30	65
(3) Topography: <u>flat</u> (Hilly) (Flat) (Level)	Coarse sand & gravel	81	146
(4) Purpose of Well: <u>domestic</u> (Domestic Irrigation Municipal, Industrial, Other)	Clay	35	181
Information upon completion of well:	Sand with clay strks.	209	390
(1) Diameter <u>6x3</u> inches.	Clay with sand strks.	25	415
(2) Total Depth <u>1458</u> feet.	Sand	145	560
(3) Water Level <u>flowing</u> feet below top of ground. <u>1263'</u> <u>07</u> <u>3"</u>	Brown clay	25	585
(4) Cased to <u>145'</u> , Size <u>6"</u> <u>1' of 6x3 swage</u>	White clay	25	610
(5) Screen: Size <u>3"</u> , Length <u>40' 5"</u> <u>3" blank 10'</u>	Clay with hard strks.	191	801
(6) Were any formations sealed against pollution? <u>yes</u> yes, _____ no.	Rock	1	802
If YES depth of formation <u>Shot at bottom</u> and packer above the screen.	Shale	12	814
Why _____	Hard rock	1	815
Drillers Remarks: _____	Shale	21	836
	Rock	1	837
	Clay with sandy strks.	38	875
	Rock	1	876
	Shale	72	948
	Sandy shale	33	981
	Shale & hard clay strks.	47	1028
	Shale with sandy strks.	62	1090
	Hard clay	10	1100
	Hard rock	1	1101
	Sandy shale	58	1159
	Hard shale	38	1197
	Shale with sandy strks.	22	1219
	Sandy shale	53	1272
	Shale	23	1295
	Shale with sandy strks.	15	1310
	Clay - white	33	1343
	Fine sand & shale	15	1358

(Use Back Side)

Well No.

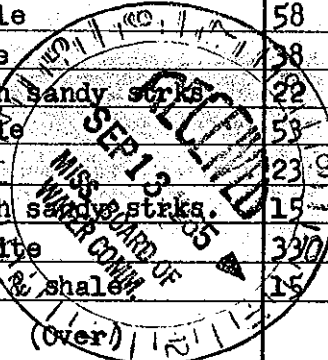

Mail this copy to Board of Water Commissioners 429 Miss. St. Jackson, Miss.