

Coahoma
 T 82
 10-66

MISSISSIPPI
 BOARD OF WATER COMMISSIONERS
 416 North State Street
 Jackson, Mississippi 39201
CODED
 WATER WELL DRILLERS LOG

10-10-1966 Lavne-Central Co. Coahoma
 date well completed firm name county well located

LANDOWNER: Clarksdale Country Club, Clarksdale, Mississippi


description of formations encountered	from	to
	Sandy clay	0
fine sand	16	35
coarse sand	35	50
coarse sand, pea gravel	50	107
sand, big gravel boulders	107	111

(mailing address)
 WELL LOCATION:
 sec. 11 T. 27 N. R. 4 E.
1 1/2 miles N of Clarksdale
 (distance) (direction) (nearest town)

WELL PURPOSE:
 (home, irrigation, municipal, industrial)

WELL COMPLETION DATA:
 (1) diameter (inches) 12"
 (2) total depth (feet) 111'
 (3) static water level (feet) 31'1" below top of ground.
 (4) casing S.S. 71'
 (material) (depth)
12" if telescope see back.
 (size)
 (5) screen 40' 71'
 (length) (depth to top)
12" Armco shutter
 (size) (material)
 (6) pump 75 750
 (HP) (yield gpm)
electricity
 (type power)
 (7) electric log no
 (yes or no)
 (organization running log)
 (8) how well bottom plugged none

CODED

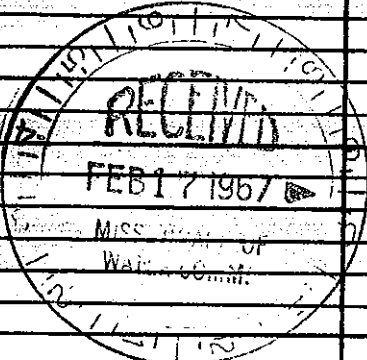

DRILLERS REMARKS: