

Coahoma
T 83
7-66

Clarksdale Quad
MISSISSIPPI BOARD OF WATER COMMISSIONERS

WATER WELL DRILLERS LOG

CODED

Date: 7-19, 1966, Driller: Five County Farmers County Coahoma
(Name)

(1) Owner of Land:	Description & Color of Materials Sand, Clay, Red Clay, Shell, etc.	Thick- ness Feet	Depth Feet
<u>MARYLAND PRTG CO</u> (Name) <u>RT-2 Box 23-B</u> <u>CLARKSDALE MISS</u> (Address)	<u>Clay -</u>		<u>46 1/2</u>
(2) Location: <u>NE 1/4, SW 1/4, Sec. 36 T4R2</u>	<u>Coarse sand</u>	<u>26</u>	<u>72 1/2</u>
<u>1</u> miles <u>S</u> , of <u>Clarksdale</u> (distance) (direction) (Nearest Town)	<u>Coarse sand + pea rock</u>	<u>13</u>	<u>85 1/2</u>
(3) Topography: <u>Flat</u> (Hilly) (Flat) (Level)	<u>Sand & bits of gravel</u>	<u>45 1/2</u>	<u>124 1/2</u>
(4) Purpose of Well: <u>IRRIGATION</u> (Domestic Irrigation Municipal, Industrial, Other)			

Information upon completion of well:


- (1) Diameter 6 inches.
- (2) Total Depth 120' feet.
- (3) Water Level 30' feet below top of ground.
- (4) Cased to 72', Size 6"
- (5) Screen: Size 6", Length 48"
- (6) Were any formations sealed against pollution?
 yes, no.

164
46
118

CODED

If YES depth of formation _____
Why _____

Drillers Remarks: _____

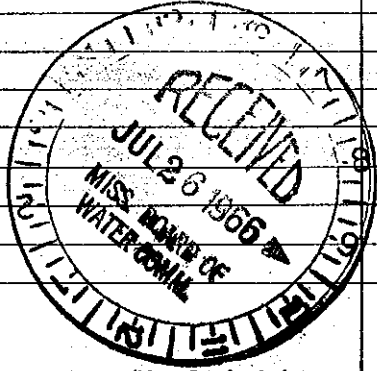

(Use Back Side)

Well No. _____