

Coahoma
T 86
4-67

MISSISSIPPI
BOARD OF WATER COMMISSIONERS
416 North State Street
Jackson, Mississippi 39201

CODED

WATER WELL DRILLERS LOG

4-13-67 date well completed
1967 Hill County Farmers firm name
Coahoma county well located

LANDOWNER: Montgomery Farms
Clarksdale Miss

description of formations encountered	from	to
<u>Depositive Sand</u>		<u>14</u>
<u>Sand</u>	<u>6 1/2</u>	<u>20 1/2</u>
<u>Sand + Clay</u>	<u>13</u>	<u>33 1/2</u>
<u>Med Sand</u>	<u>13</u>	<u>46 1/2</u>
<u>Sand + gravel</u>	<u>68 1/2</u>	<u>115 1/2</u>
<u>Bedded Rock at 115'</u>		

(mailing address)

WELL LOCATION:


sec 7 T 27 N R 4 W
3 1/4 miles SE of Farewell
(distance) (direction) (nearest town)

WELL PURPOSE: Irrigation
(home, irrigation, municipal, industrial)

WELL COMPLETION DATA:

- (1) diameter (inches) 6
- (2) total depth (feet) 111 1/2
- (3) static water level (feet) 20 ¹⁰ below top of ground.
- (4) casing pipe 63 1/2
(material) (depth)
6 (size) If telescope see back.
- (5) screen 48 63 1/2
" (length) (depth to top)
10 Deen Screen
(size) (material)
- (6) pump 30 1000
(HP) (yield gpm)
Tractor
(type power)
- (7) electric log NO
(yes or no)
- (8) how well bottom plugged welded

CODED

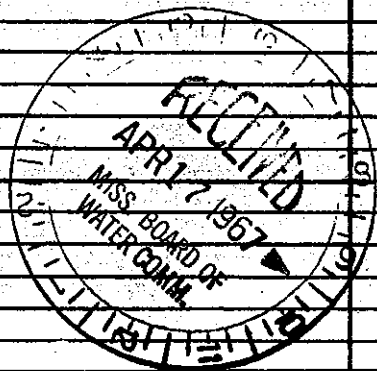

DRILLERS REMARKS: