

Coahoma
 J 88
 11-67

MISSISSIPPI
 BOARD OF WATER COMMISSIONERS
 416 North State Street
 Jackson, Mississippi 39201

WATER WELL DRILLERS LOG **CODED**

11-14 1967 Five County Farmers Assoc - Coahoma
 date well completed firm name county well located

LANDOWNER: John Garmon
 Clarksdale
 Miss
 (mailing address)

description of formations encountered	from	to
Clay + Red Sand		20 1/2
fine sand	20 1/2	27
MD Sand	27	33 1/2
MD sand + pea rock	33 1/2	46 1/2
FINE SAND	46 1/2	85 1/2
fine sand	85 1/2	89
Coarse sand + gravel	89	116
fine white sand	116	124
sand + pea rock	124	131

WELL LOCATION:
 sec. 10 T 27 N R. 4 W
 1 miles W of Clarksdale
 (distance) (direction) (nearest town)

WELL PURPOSE: irrigation
 (home, irrigation, municipal, industrial)

WELL COMPLETION DATA:

(1) diameter (inches) 16

(2) total depth (feet) 127.2"

(3) static water level (feet) 17 below top of ground.

(4) casing Pipe 79.2" (material) (depth)
 16 (size) If telescope see back.


(5) screen 48' 79.2" (length) (depth to top)
 16 (size) Over 101 (material)

(6) pump (HP) (yield gpm)
 (type power)

(7) electric log (yes or no)
 (organization running log)

(8) how well bottom plugged Welded

CODED

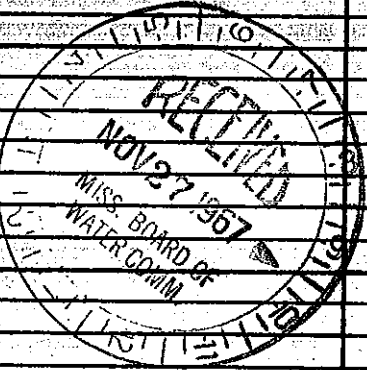

DRILLERS REMARKS: