

COAHOMA MISSISSIPPI BOARD OF WATER COMMISSIONERS

J94
2-10-64

WATER WELL DRILLERS LOG CODED


Date: 2-10-1964, Driller: Full County Turner ^{last} Coalovera
(Name)

(1) Owner of Land: Leon Brantlett
(Name)
Clarksdale Miss
(Address)
(2) Location: 1/4 mi S with 32/27 4 Sec. 32 T. R
Dorment of
(distance) (direction) (Nearest Town)
(3) Topography: Flat
(Hilly) (Flat) (Level)
(4) Purpose of Well: Irrigation
(Domestic Irrigation
Municipal, Industrial, Other)

Description & Color of Materials Sand, Clay, Red Clay, Shell, etc.	Thick- ness Feet	Depth Feet
<u>0-15' Buckshot</u>		
<u>15-60' Sand</u>		
<u>60-105 1/2' Coarse Sand and small shoval</u>		

Information upon completion of well:

(1) Diameter 6 inches.
(2) Total Depth 105 1/2 feet.
(3) Water Level 20' feet below top of ground.
(4) Cased to 58, Size 6"
(5) Screen: Size 6", Length 48'
(6) Were any formations sealed against pollution?
 yes, no.

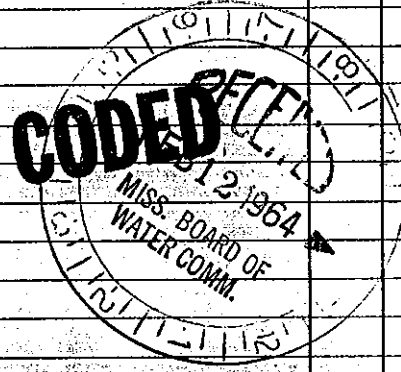

If YES depth of formation _____
Why _____
Drillers Remarks: _____
SL Adams

(Use Back Side)

Well No.

Mail this copy to Board of Water Commissioners 429 Miss. St. Jackson, Miss