

Cochran
J 109
2-9-81

MISSISSIPPI DEPARTMENT OF NATURAL RESOURCES

Bureau of Land and Water Resources

GW 6491 SE/SE, Sec. 28 21

T27N, R4W

Southport Mall

P.O. Box 10631

Jackson, Mississippi 39209

WATER WELL DRILLERS LOG

CODED

Elev. 160

2-9-81 date well completed
 Fine Co. Farmers Co. firm name
 Cochran county well located

LANDOWNER: King Anderson

Bakert Co.

Chickadee Run
 (mailing address)

description of formations encountered

from to

top clay	0	10
fine sand	10	16
clay	16	57
red sand	57	74
coarse sand	74	85
sand & gra	85	120

WELL LOCATION:

2128 27 N sec. 28 T 27 N R 4 W
2 miles SW of Cade
 (distance) (direction) (nearest town)


WELL PURPOSE:

(home, irrigation, municipal, industrial)

WELL COMPLETION DATA:

- diameter (inches) 8
- total depth (feet) 120'
- static water level (feet) 20.5 below top of ground.
- casing PVC 50'
 (material) (depth)
8" if telescope see back.
 (size)
- screen 80' 80'
 (length) (depth to top)
8" PVC
 (size) (material)
- pump 20 1000
 (HP) (yield gpm)
disc
 (type power)
- electric log no
 (yes or no)
 (organization running log)
- how well bottom plugged cap

CODED

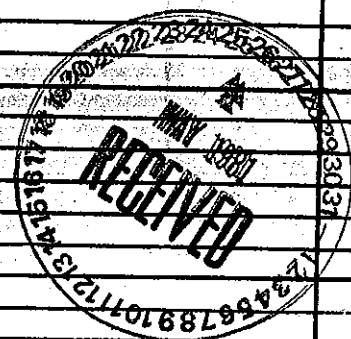

DRILLERS REMARKS: