

COAHOMA MISSISSIPPI BOARD OF WATER COMMISSIONERS

K
9-16-64
WATER WELL DRILLERS LOG

COAHOMA

Date: Sept 16, 1964, Driller: Robert E. Raloff County Stennis
(Name)

(1) Owner of Land: <u>Mr. Curry</u> (Name)	Description & Color of Materials Sand, Clay, Red Clay, Shell, etc.	Thick- ness Feet	Depth Feet
<u>Clarksdale, Miss</u> (Address)	<u>Gravel</u>	<u>0</u>	<u>8</u>
(2) Location: <u>1/4</u> , <u>1/4</u> , Sec. <u>T</u> <u>R</u>	<u>Brown sand</u>	<u>8</u>	<u>35</u>
<u>5</u> miles <u>East</u> , of <u>Clarksdale</u> (distance) (direction) (Nearest Town)	<u>Sand & Gravel</u>	<u>35</u>	<u>79</u>
(3) Topography: <u>Level</u> (Hilly) (Flat) (Level)			
(4) Purpose of Well: <u>Domestic</u> (Domestic Irrigation Municipal, Industrial, Other)			


Information upon completion of well:

- (1) Diameter 4 inches. plastic
- (2) Total Depth 75 feet.
- (3) Water Level 15 feet below top of ground.
- (4) Cased to 75, Size 4
- (5) Screen: Size 4", Length 28
- (6) Were any formations sealed against pollution?
 yes, no.

If YES depth of formation _____

Why _____

Drillers Remarks: _____

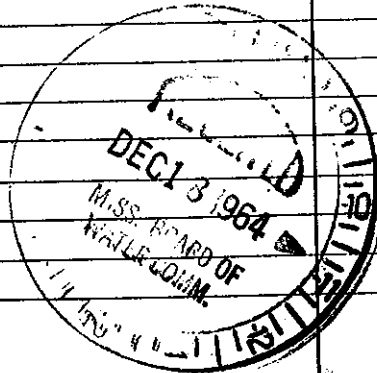

(Use Back Side)

Well No.

Mail this copy to Board of Water Commissioners 429 Miss. St. Jackson, Miss.