

COAHOMA MISSISSIPPI BOARD OF WATER COMMISSIONERS

~~K 0003~~


7-22-62

WATER WELL DRILLERS LOG

Date 7/22, 1962, Driller: FIVE COUNTY FARMERS ASSN County Cockama

(Name)

| (1) Owner of Land | Description & Color of Materials Sand, Clay, Red Clay, Shell, etc. | Thick- ness Feet | Depth Feet |
|---|---|------------------------|---------------|
| <u>J. T. Mossey</u> (Name) <u>Lyon, Miss</u> (Address) | <u>Silt & clay</u> | <u>29</u> | <u>29</u> |
| | <u>Fine Sand</u> | <u>41</u> | <u>70</u> |
| | <u>Coarse Sand, P. Gravel</u> | <u>38</u> | <u>108</u> |
| (2) Location: <u>1/4</u> , <u>1/4</u> , Sec. <u>T</u> , R <u>R</u> | | | |
| <u>6</u> miles <u>E</u> of <u>Lyon</u> (distance) (direction) (Nearest Town) | | | |
| (3) Topography: <u>✓</u> (Hilly) (Flat) (Level) | | | |
| (4) Purpose of Well: <u>irrigation</u> (Domestic Irrigation Municipal, Industrial, Other) | | | |

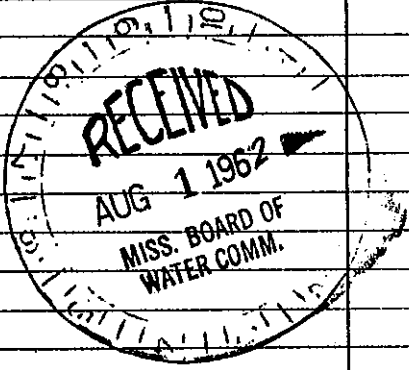

Information upon completion of well:

(1) Diameter 6 inches.

(2) Total Depth 108 feet.

(3) Water Level 12 feet below top of ground.

(4) Cased to 60, Size 6

(5) Screen: Size 6", Length 48"

(6) Were any formations sealed against pollution?
 yes, no.

If YES depth of formation _____

Why _____

Drillers Remarks: _____

(Use Back Side)

Well
3%

Mail this copy to Board of Water Commissioners 429 Miss. St. Jackson, Miss.