

COAHOMA MISSISSIPPI BOARD OF WATER COMMISSIONERS

K0002

7-20-62

WATER WELL DRILLERS LOG

Date: 7/20, 1962, Driller: FIVE COUNTY FARMERS ASSN. Coahoma

(Name)

(1) Owner of Land: J. T. Morrey
(Name)
Reynolds, Miss
(Address)

(2) Location: 1/4, 1/4, Sec. T R,
6 miles E of Lynn
(distance) (direction) (Nearest Town)

(3) Topography: Level
(Hilly) (Flat) (Level)

(4) Purpose of Well: irrigation
(Domestic Irrigation
Municipal, Industrial, Other)

Description & Color of Materials Sand, Clay, Red Clay, Shell, etc.	Thick- ness Feet	Depth Feet
<u>Silt & clay</u>	<u>32</u>	<u>32</u>
<u>Fine Sand</u>	<u>40</u>	<u>72</u>
<u>Coarse Sand P. Hard</u>	<u>36</u>	<u>108</u>


Information upon completion of well:

- (1) Diameter 6 inches.
(2) Total Depth 108 feet.
(3) Water Level 12 feet below top of ground.
(4) Cased to 60, Size 6"
(5) Screen: Size 6", Length 48
(6) Were any formations sealed against pollution?
yes, no.

If YES depth of formation _____

Why _____

Drillers Remarks: _____

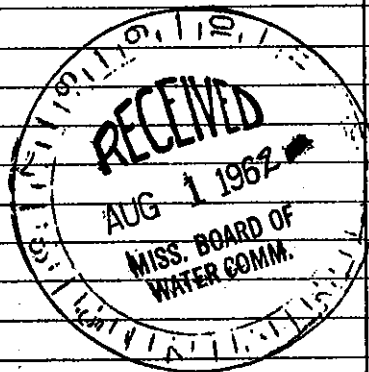

(Use Back Side)

Well No. 2

Mail this copy to Board of Water Commissioners 429 Miss. St. Jackson, Miss