

COAHOMA MISSISSIPPI BOARD OF WATER COMMISSIONERS

K20

4-28-61

WATER WELL DRILLERS LOG

CODED

Date: April 28, 1961, Driller: Layne-Central Company County Coahoma

(Name)


Company		Description & Color of Materials Sand, Clay, Red Clay, Shell, etc.	Thick- ness Feet	Depth Feet
(1) Owner of Land:	(Name)			
<u>Planters Manufacturing</u>		<u>Clay</u>	<u>22</u>	<u>22</u>
<u>Clarksdale, Mississippi</u>		<u>Sand</u>	<u>2</u>	<u>24</u>
<u>T27N</u>		<u>Clay</u>	<u>10</u>	<u>34</u>
(2) Location: <u>1/4</u> , <u>1/4</u> , Sec. <u>18</u> T. <u>R3W</u>		<u>Coarse sand</u>	<u>46</u>	<u>80</u>
<u>miles</u> , of <u>Lyon</u>		<u>Sand & gravel</u>	<u>45</u>	<u>125</u>
(distance) (direction) (Nearest Town)				
(3) Topography: <u>flat</u>				
(Hilly) (Flat) (Level)				
(4) Purpose of Well: <u>cooling well</u>				
(Domestic Irrigation Municipal, Industrial, Other)				
<u>industrial</u>				

Information upon completion of well:

- (1) Diameter 12x10 inches.
- (2) Total Depth 120' feet.
- (3) Water Level 30' feet below top of ground.
- (4) Cased to 80', Size 12"
- (5) Screen: Size 10", Length 40'
- (6) Were any formations sealed against pollution?
Shallow water for cooling only.
yes, no.
Sealed at the top.
If YES depth of formation _____
- Why _____
- Drillers Remarks: _____

CODED

CODED

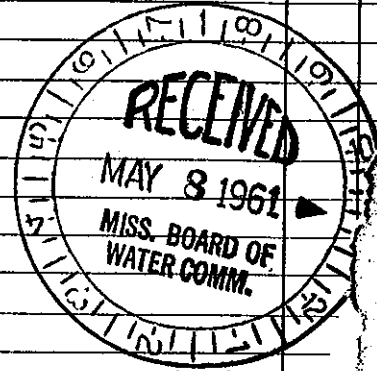

(Use Back Side)

Mail this copy to Board of Water Commissioners 429 Miss. St. Jackson