

COAHOMA MISSISSIPPI BOARD OF WATER COMMISSIONERS

K. 21 GW 5567

WATER WELL DRILLERS LOG

3-14-63 Elev. 165


3/16/63 CODED

Date: March 14, 1963, Driller: Layne-Central Company Coahoma

(Name)

(1) Owner of Land: <u>Planters Manufacturing Company</u> (Name)	Description & Color of Materials Sand, Clay, Red Clay, Shell, etc.	Thick- ness Feet	Depth Feet
<u>Clarksdale, Mississippi</u> (Address)	Sandy clay	6	6
(2) Location: <u>NW 1/4, SE 1/4, Sec. 18 T27N R3W</u>	Clay	16	22
_____ miles _____ of _____ (distance) (direction) (Nearest Town)	Brown sand	19	41
(3) Topography: <u>flat</u> (Hilly) (Flat) (Level)	Coarse sand <i>14-1</i>	24	65
(4) Purpose of Well: <u>industrial</u> (Domestic Irrigation Municipal, Industrial, Other)	Coarse sand & pea gravel	69	134
Information upon completion of well:	Rock	1	135
(1) Diameter <u>12 x 8</u> inches.	Sand & gravel	31	166
(2) Total Depth <u>625' - 10"</u> feet.	Rock	2	168
(3) Water Level <u>37'</u> feet below top of ground.	Sand	1	169
(4) Cased to <u>566' - 7"</u> , Size <u>12"</u> <u>80'</u> " <u>8"</u>	Clay	34	203
(5) Screen: Size <u>8"</u> , Length <u>50'</u>	Clay & strks. sand	15	218
(6) Were any formations sealed against pollution? <u>yes</u> yes, <u>no</u> no.	Sand	69	287
If YES depth of formation <u>Cemented full</u> length of the casing.	Clay	37	324
Why _____	Clay & strks. sand	57	381
Drillers Remarks: _____	Shale & fine sand	54	435
_____	Clay	11	446
_____	Sand	185	631
_____	Clay	21	652
_____	_____	_____	_____
_____	_____	_____	_____
CODED

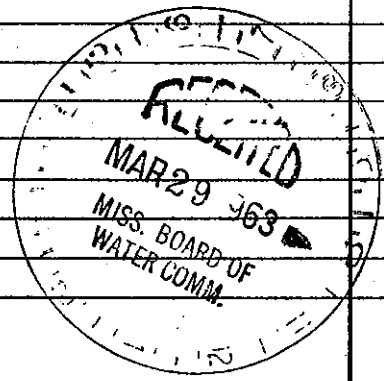

(Use Back Side)

Well No.

Mail this copy to Board of Water Commissioners 429 Miss. St. Jackson, Miss.