

COAHOMA

K22

10-7-61

MISSISSIPPI BOARD OF WATER COMMISSIONERS

WATER WELL DRILLERS LOG

COAHOMA

CODED

Date: 10/7, 1961, Driller: Bailey Drilling Co. County: COAHOMA
(Name)

(1) Owner of Land: Lyon, Miss.
(Name)
Lyon, Miss.
(Address)

(2) Location: SW 1/4, NE 1/4, Sec. 18 T21 R3
in Lyon
miles (distance) of (direction) (Nearest Town)

(3) Topography: Flat
(Hilly) (Flat) (Level)

(4) Purpose of Well: Municipal
(Domestic Irrigation) (Municipal, Industrial) (Other)

Description & Color of Materials Sand, Clay, Red Clay, Shell, etc.	Thick- ness Feet	Depth Feet
Clay	10	10
Sand	80	90
Gravel + Sand		200
Sand + Mud		220
Sand		312
Lignite		335
Sand		375
Lignite + mud		400
Sand		572
Mud		596
Mud + Sand		605
CODED		660
CODED		670
Sand + Mud		715
Green Sand + Mud		756
Black Mud		812
Mud		889
Sand + Mud		1165
Sand		1242

Information upon completion of well:

(1) Diameter 6x4 inches.

(2) Total Depth 1242 feet.


(3) Water Level 5 + 30 feet below top of ground.

(4) Cased to all way size 6x4.

(5) Screen: Size 4, Length 40ft

(6) Were any formations sealed against pollution?
_____ yes, X no.

wood (2ft) at 95-97
Rocks as follows
1ft at 812, 8ft at 860
7ft at 882, 5ft at
945, 10ft at 740

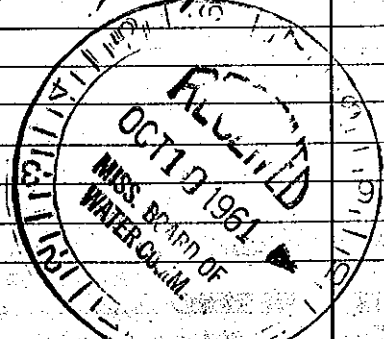

(Use Back Side)

Well No.