

COAHOMA MISSISSIPPI BOARD OF WATER COMMISSIONERS

K30

7-19-63

WATER WELL DRILLERS LOG

K


Date: 7-19, 1963, Driller: Five County Farmers Assn Coahoma
(Name)

	Description & Color of Material Sand, Clay, etc.	Thick- ness Feet	Depth Feet
(1) Owner of Land: <u>JH Pruitt</u> (Name) <u>R.D. Ryan Miss</u> (Address) <u>21 28 29 26 4</u>	CODED <u>6 IN B...</u>	<u>0</u>	<u>16 1/2</u>
	<u>BLUE MUD</u>	<u>16 1/2</u>	<u>32</u>
	<u>SAND</u>	<u>32</u>	<u>36</u>
(2) Location: <u>1/4</u> , <u>1/4</u> , Sec. <u>26 27 28 29 30</u> <u>T27R3</u>	<u>SAND TOP Mud Bottom</u>	<u>36</u>	<u>42 1/2</u>
<u>4</u> miles <u>East</u> of <u>Chickadee</u> (Distance) (direction) (Nearest Town)	<u>BLUE MUD</u>	<u>42 1/2</u>	<u>58</u>
	<u>FINE SAND</u>	<u>58</u>	<u>62</u>
(3) Topography: <u>Flat</u> (Hilly) (Flat) (Level)	<u>COARSE SAND & Rock</u>	<u>62</u>	<u>75</u>
(4) Purpose of Well: <u>Irrigation</u> (Domestic, Irrigation, Municipal, Industrial, Other)	<u>Heavy Sand & Rock</u>	<u>75</u>	<u>108</u>

CODED

Information upon completion of well:

- (1) Diameter 14 inches.
- (2) Total Depth 108 feet.
- (3) Water Level 15 feet below top of ground.
- (4) Cased to 60, Size 14"
- (5) Screen: Size 12", Length 48
- (6) Were any formations sealed against pollution?
no.

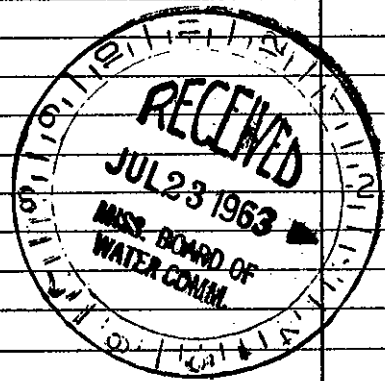

If YES depth of formation _____

Why _____

Drillers Remarks: SC Pruitt

Well No.

(Use Back Side)

Mail this copy to Board of Water Commissioners 429 Miss. St. Jackson, Miss