

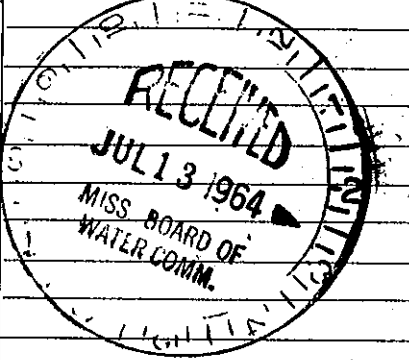
COAHOMA MISSISSIPPI BOARD OF WATER COMMISSIONERS

K 34

WATER WELL DRILLERS LOG

CODED

Date: 6/15, 1964, Driller: Delta Well Supply County Coahoma
 (Name)

(1) Owner of Land:	Description & Color of Materials Sand, Clay, Red Clay, Shell, etc.	Thick- ness Feet	Depth Feet
<u>N. Massey</u> (Name) <u>Leans Well</u> (Address)	<u>sandy top, calc. shell</u>	<u>27</u>	
(2) Location: <u>1/4</u> , <u>1/4</u> , Sec. <u>24</u> T <u>22</u> R <u>3</u> , <u>4</u> miles <u>East</u> , of <u>Clarksden</u> (distance) (direction) (Nearest Town)	<u>fine sand clay</u> <u>Breaker</u> <u>Sand M.</u> <u>1" + gravel</u>	<u>24</u> <u>16</u> <u>52</u>	<u>51</u> <u>77</u> <u>129</u>
(3) Topography: _____ (Hilly) (Flat) (Level)			
(4) Purpose of Well: <u>Irrigation</u> (Domestic Irrigation, Municipal, Industrial, Other)			
Information upon completion of well:			
(1) Diameter <u>12</u> inches.			
(2) Total Depth <u>129</u> feet.			
(3) Water Level <u>21</u> feet below top of ground.			
(4) Cased to _____, Size _____			
(5) Screen: Size <u>12</u> , Length <u>40</u>			
(6) Were any formations sealed against pollution? _____yes, _____no.			
If YES, depth of formation _____			
Why _____			
Drillers Remarks: _____			

Well # 2

CODED

Well No.

(Use Back Side)

Mail this copy to Board of Water Commissioners 429 Miss. St. Jackson, Miss.