

COAHOMA

MISSISSIPPI BOARD OF WATER COMMISSIONERS

~~A~~K35


WATER WELL DRILLERS LOG

COAHOMA

11-13-61

Date: 11/13, 1961, Driller: Bailey Drilling Co County: Washington
(Name)

(1) Owner of Land: <u>Mrs. B. M. Bobo</u> (Name) <u>Clarksdale Miss.</u> (Address) 1 26 3	Description & Color of Materials Sand, Clay, Red Clay, Shell, etc.	Thick- ness Feet	Depth Feet
	Clay	21	21
	Sand	69	90
	Sand + gravel	96	186
	Mud	64	250
(2) Location: $\frac{1}{4}$, $\frac{1}{4}$, Sec. <u>35, 36 T. 22 R. 3</u> , <u>5</u> miles <u>S E</u> , of <u>Clarksdale</u> , (distance) (direction) (Nearest Town)	Sand + Mud	30	280
	Sand	105	385
(3) Topography: <u>flat</u> (Hilly) (Flat) (Level)	Mud	143	528
(4) Purpose of Well: <u>Domestic</u> (Domestic Irrigation Municipal, Industrial, Other)	Sand + Mud	41	569
	Mud	29	598
	Mud + Sand	17	615
	Mud	16	631
	Sand + Mud	19	650
	Sand	83	733
	Sand + Mud	41	774
	Mud	146	920
	Sand	160	1080
	Rock at 580, 588, 590, 598 Rocks 615 to 620		
Information upon completion of well: (1) Diameter <u>4x2 1/2 x 2</u> inches. (2) Total Depth <u>1070</u> feet. (3) Water level <u>at ground level</u> feet below top of ground. (4) Cased to <u>all way</u> Size <u>4x2 1/2 x 2</u> (5) Screen: Size <u>2</u> , Length <u>40 ft.</u> (6) Were any formations sealed against pollution? <u>yes</u> , <input checked="" type="checkbox"/> <u>no</u> . If YES depth of formation _____ Why _____ Drillers Remarks: _____			

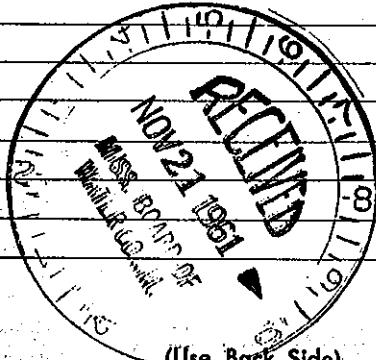

Well No.

Mail this copy to Board of Water Commissioners 429 Miss. St. Jackson, Miss