

COAHOMA


K 36

MISSISSIPPI BOARD OF WATER COMMISSIONERS

11-3-65

WATER WELL DRILLERS LOG

Date: Nov 3, 1965, Driller: Lisle County, Georgia

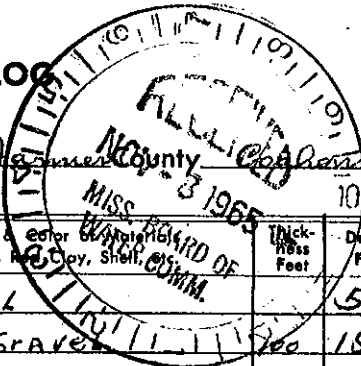

(1) Owner of Land: Allis Chalmers (Name)

Highway 61 North Clarkdale (Address)

(2) Location: 1/4, 1/4, Sec. 5 T27R 3

1 1/2 miles North of Lyon (direction) (Nearest Town)

(3) Topography: Flat (Hilly) (Flat) (Level)

(4) Purpose of Well: Private water supply (Domestic Irrigation, Municipal, Industrial, Other)

Description of Sand, Clay, etc.	Thickness Feet	Depth Feet
TOPSOIL		51
SAND + GRAVEL	300	151
CLAY	38	189
SAND + SHALE	58	247
CLAY	9	257
SAND	47	303
LIGNITE	27	330
SAND	23	353
CLAY	77	430
MUCKY SAND w/ CLAY STRINGS	41	471
CLAY	33	504
MURKY SAND	43	547
GOOD SAND	99	646
ROCK + SAND - ROCK THIN SHEETS	19	665
ROCK + CLAY (3" to 14" THICK)	11	676
MUCKY SAND + ROCK	22	698
GOOD SAND	21	719
MUCKY SAND + ROCK	30	849
MUD	65	914
CLAY	129	1043
SAND -	130	1173

Information upon completion of well:

(1) Diameter: 2 1/2 x 3 x 4 inches.

(2) Total Depth: 1160 feet.

(3) Water Level: 22" feet below top of ground.

(4) Cased to: 1130, Size 126 #, 2 1/2 x 5" Backwash Pipe

(5) Screen: Size 2 1/2, Length 30

(6) Were any formations sealed against pollution? X yes, no.

If YES depth of formation 22'

Why SANITATION

Drillers Remarks:

Handwritten signature

(Use Back Side)

Well No.