

COAHOMA

K37

MISSISSIPPI BOARD OF WATER COMMISSIONERS

10-20-65

WATER WELL DRILLERS LOG

Date: Oct. 20, 1965, Driller: Five Co. Farmers Assn. County Coahoma

(Name)

(1) Owner of Land: Five County Farmers  
(Name)  
P. O. Box 758 Clarksdale, Miss.  
(Address)

(2) Location: 30/27/3 25 T27R 4,  
3 miles South of Clarksdale  
(distance) (direction) (Nearest Town)

(3) Topography: Flat  
(Hilly) (Flat) (Level)

(4) Purpose of Well: company private use.  
(Domestic Irrigation  
Municipal, Industrial, Other)

Description & Color of Materials Sand, Clay, Red Clay, Shell, etc.	Thick- ness Feet	Depth Feet
top soil & clay		0-32
sand		86
coarsesand <sup>86</sup>		100
pea gravel & coarse sand		113
rock		114' 3"
gravel and sand		118
clay with few boulders		183
fine sand & clay		257
med sand		263
clay		312
sand		332
clay		386
sand		413
clay		416
sand		489
clay shale & sand		506
clay shale & sand		550
sand		629
clay		678
sand		764
rock & clay	6"	785
clay		807
rock		807' 10"
clay		829
rock		830
murky sand & shale		1047
sand		1165
clay		1175

Information upon completion of well:

(1) Diameter: 2 1/2 - 3 - 6 inches.

(2) Total Depth: 1163 feet.

(3) Water Level: 3' feet below top of ground.  
229' 2 1/2"  
624' 3"

(4) Cased to: 1133, Size: 94' 6"


(5) Screen: Size 2 1/2, Length 30

(6) Were any formations sealed against pollution?  
X yes,        no.

If YES depth of formation: 32'

Why: Sanitation

Drillers Remarks:

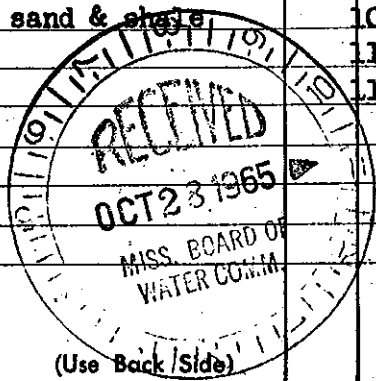

Well No.

Mail this copy to Board of Water Commissioners 429 Miss. St. Jackson, Miss.