

COAHOMA MISSISSIPPI BOARD OF WATER COMMISSIONERS

K 39

7-10-65

WATER WELL DRILLERS LOG **CODED**

Date: 7-10, 1965, Driller: Fifth Century Farmers County: Coahoma  
(Name)


(1) Owner of Land: EM Gerger  
(Name)  
Clarksdale Miss  
(Address)

(2) Location: 1/4, 1/4, Sec. 4.5, T22R<sup>3</sup>  
4 miles North, of Clarksdale  
(distance) (direction) (Nearest Town)

(3) Topography: Flat  
(Hilly) (Flat) (Level)

(4) Purpose of Well: Irrigation  
(Domestic Irrigation) (Municipal, Industrial, Other)

Description & Color of Materials Sand, Clay, Red Clay, Shell, etc.	Thick- ness Feet	Depth Feet
Buckshot	27 1/2	27 1/2
Blue mud.	13	40 1/2
FINE SAND	62	92 1/2
Big gravel & coarse sand	57 1/2	150 1/2

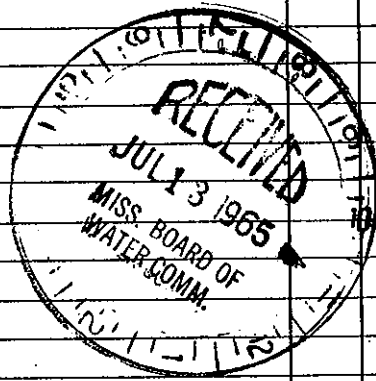

**CODED**

Information upon completion of well:

(1) Diameter 6 inches.

(2) Total Depth 151 feet.

(3) Water Level 18" feet below top of ground.

(4) Cased to 103, Size 6.

(5) Screen: Size 1/2, Length 48.

(6) Were any formations sealed against pollution?  
 yes,  no.

If YES depth of formation \_\_\_\_\_

Why \_\_\_\_\_

Drillers Remarks: \_\_\_\_\_

*[Signature]*

(Use Back Side)

Well No.

Mail this copy to Board of Water Commissioners 429 Miss. St. Jackson, Miss.