

COAHOMA MISSISSIPPI BOARD OF WATER COMMISSIONERS

K 42

8-27-63

WATER WELL DRILLERS LOG

CODED

Date: AUG. 27, 1963, Driller: DELTA DRILLING CO. County COAHOMA
(Name)

(1) Owner of Land: J. B. (JOHN) LANEY
(Name)
LYON, MISS.
(Address)

(2) Location: NE 1/4, NW 1/4, Sec. 15 T27R34
_____ miles _____ of _____
(distance) (direction) (Nearest Town)

(3) Topography: _____
(Hilly) (Flat) (Level)

(4) Purpose of Well: DOMESTIC
(Domestic Irrigation
Municipal, Industrial, Other)

Description & Color of Materials Sand, Clay, Red Clay, Shell, etc.	Thick- ness Feet	Depth Feet
GUMBO	21	21
SAND	83	104
GRAVEL	30	134
GUMBO	33	167
SAND	158	335
GUMBO	43	378
SHALE	48	426
GUMBO w/4" ROCK @ 490'	78	504
SHALE	61	565
GUMBO	49	614
SHALE w/6" ROCK @ 708'	106	720
SAND	18	738
SHALE	90	828
GUMBO	20	848
SAND	10	858
SHALE	14	872
SAND	4	876
GUMBO	23	899
SHALE	20	919
GUMBO	20	939
SHALE	20	959
SAND	28	987
GUMBO	12	999
SAND	40	1039
SHALE	15	1054
SAND - WHOLE	86	1140

Information upon completion of well:

(1) Diameter 4 inches.

(2) Total Depth 1140 feet.

(3) Water Level FLOWS feet below top of ground.

(4) Cased to 1120, Size 4" - 84', 3" - 609', 2" - 442'


(5) Screen: Size 2", Length 20'

(6) Were any formations sealed against pollution?
_____ yes, _____ no.

If YES depth of formation _____

Why _____

Drillers Remarks: 15' LAP OF 2" IN 3"
PIPE - 1-4" X 3" STEEL REDUCER
1-3" X 2" LEAD SEAL
21' 2" TAIL PIPE ON
BOTTOM OF WELL

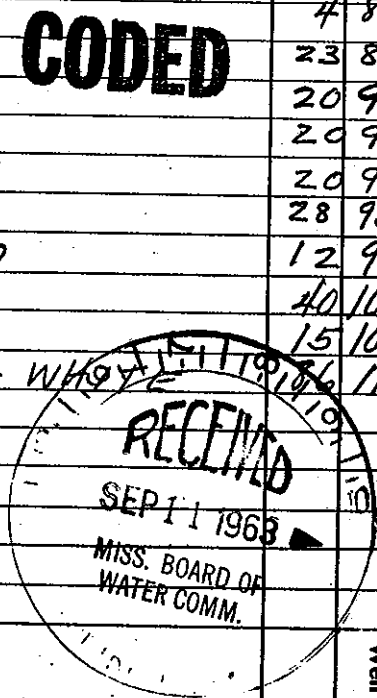

(Use Back Side)

Well No.

Mail this copy to Board of Water Commissioners. 429 Miss. St. Jackson, Miss.