

COAHOMA

K 43

MISSISSIPPI BOARD OF WATER COMMISSIONERS


12-2-65

WATER WELL DRILLERS LOG **CODED**

Date: DEC 2, 1965, Driller: DELTA DRILLING Co County COAHOMA

(Name)

(1) Owner of Land: <u>A.A. WESTBROOK</u> (Name)	Description & Color of Materials Sand, Clay, Red Clay, Shell, etc.	Thick- ness Feet	Depth Feet
<u>LYON, MISS</u> (Address)	Gumbo	17	17
(2) Location: <u>NE 1/4, NE 1/4, Sec. 32 T20R3W</u>	Sand	65	82
_____ miles _____ of _____ (distance) (direction) (Nearest Town)	gravel	84	166
(3) Topography: _____ (Hilly) (Flat) (Level)	gumbo	90	256
(4) Purpose of Well: <u>DOMESTIC</u> (Domestic Irrigation Municipal, Industrial, Other)	Sand	38	294
Information upon completion of well:	Shale	14	308
(1) Diameter: <u>4</u> inches.	Sand	45	353
(2) Total Depth: <u>1144</u> feet.	Shale	43	396
(3) Water Level: <u>FLOWS</u> feet below top of ground.	Sand	58	454
(4) Cased to: <u>1124'</u> Size <u>2"-542</u>	gumbo	90	544
(5) Screen: Size <u>2"</u> , Length <u>20'</u>	Shale	12	556
(6) Were any formations sealed against pollution? _____ yes, _____ no.	Gumbo w/Rock	70	626
If YES depth of formation _____	Sand w/Rock	56	682
Why _____	Shale	40	722
Drillers Remarks: <u>18' LAP OF 2" IN</u>	Sand	52	774
<u>3" PIPE -</u>	Shale	26	800
	gumbo w/10" Rock	52	852
	Shale	48	930
	Sand	26	956
	gumbo	40	996
	SAND	64	1060
	Shale	40	1100
	Sand	44	1144

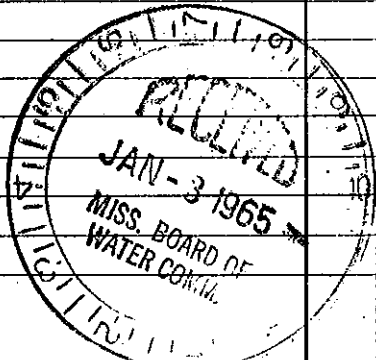

Well No.

Mail this copy to Board of Water Commissioners 429 Miss. St. Jackson, Miss