


GW - 4742  
 SE/4NW, Sec. 5, T27N, R3W  
 Elev. 170

MISSISSIPPI  
 BOARD OF WATER COMMISSIONERS  
 416 North State Street  
 Jackson, Mississippi 39201

WATER WELL DRILLERS LOG

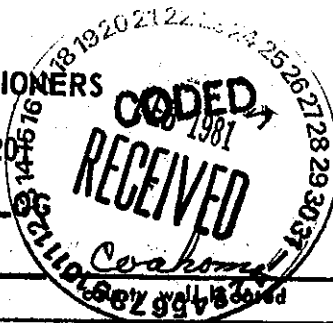

Coahoma  
 K 60  
 12/23/80

12-23-80 date well completed  
 80 Sun & Farmer Clean firm name

LANDOWNER: <u>Fred Rogers</u>	description of formations encountered	from	to
<u>Clarksdale, Miss</u> (mailing address)			
	<u>Clay</u>	<u>0</u>	<u>8</u>
	<u>fine sand</u>	<u>8</u>	<u>21</u>
	<u>Med sand</u>	<u>21</u>	<u>48</u>
	<u>Coarse sand</u>	<u>48</u>	<u>67</u>
	<u>sand &amp; gra</u>	<u>67</u>	<u>112</u>
WELL LOCATION: sec <u>5</u> T <u>27</u> N R <u>3</u> E <u>1</u> miles <u>North</u> of <u>Sun</u> (distance) (direction) (nearest town)			
WELL PURPOSE: (home, irrigation, municipal, industrial)			
WELL COMPLETION DATA: (1) diameter (inches) <u>12"</u> (2) total depth (feet) <u>112'</u> (3) static water level (feet) <u>23</u> <sup>below</sup> above top of ground. (4) casing <u>Steel</u> , <u>67'</u> (material) (depth) <u>12"</u> if telescope see back. (size) (5) screen <u>50'</u> , <u>82'</u> (length) (depth to top) <u>12"</u> , <u>Steel-Bronze</u> (size) (material) (6) pump <u>40</u> , <u>850</u> (HP) (yield gpm) <u>diesel</u> (type power) (7) electric log <u>no</u> (yes or no) (organization running log) (8) how well bottom plugged <u>sealed</u>			
DRILLERS REMARKS:			

DEPT. OF NATURAL RESOURCES  
 BUREAU OF LAND & WATER RESOURCES

FEB 23 1981  
 RECEIVED