


GW-4741

NE/NE, Sec. 6
T27N, R3W

MISSISSIPPI
BOARD OF WATER COMMISSIONERS

Elev. 416 North State Street
175 Jackson, Mississippi 39201

WATER WELL DRILLERS LOG

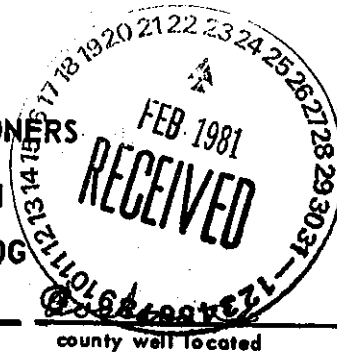

Coahoma
K 61
12/20/80

date well completed

1981 Five Co Farm Co

firm name

county well located

LANDOWNER: Fred Rogers

Clarksdale Miss.

(mailing address)

WELL LOCATION:

sec. 5 T27N R3E S3E

1 miles North of Syen
(distance) (direction) (nearest town)

WELL PURPOSE:

(home, irrigation, municipal, industrial)

WELL COMPLETION DATA:

- (1) diameter (inches) 12"
- (2) total depth (feet) 110
- (3) static water level (feet) 23 ⁵feet above top of ground
- (4) casing Steel 60' (material) (depth)
12" (size) if telescope see back.
- (5) screen 50' (length) 100' (depth to top)
12" (size) Steel-60 slot (material)
- (6) pump 40 (HP) 850 (yield gpm)
Diesel (type power)
- (7) electric log NO (yes or no)

(organization running log)

(8) how well bottom plugged well

DRILLERS REMARKS:

description of formations encountered	from to	
Clay	0	11
Fine sand	11	24
Med sand	24	30
Coar sand	30	64
Sand & Gr	64	110

DEPT. OF NATURAL RESOURCES
BUREAU OF LAND & WATER RESOURCES

