

County: Coahoma
 Permit #: GW43359
 Driller: Irrigation Equipment
 Date drilling completed: 6-12-09

State Well Report

Part 1

Mississippi Department of Environmental Quality
 Office of Land and Water Resources
 P.O. Box 10631
 Jackson, MS 39289-0631
 (601)961-5210
 (601)354-6938 (fax)

For Office Use Only:
 Aquifer: _____
 Well #: K98
 L. S. Elevation: _____
 E-log #: _____

State Law requires that this report be prepared by the driller in detail and filed with the Department within 30 days of completion of drilling of the well.

Well Owner Information		Well Location	
Owner Name: <u>Yancey Yantey Farm Partners</u>	Latitude: <u>34° 10' 56"</u>	Longitude: <u>90° 30' 43"</u>	
Mailing Address: <u>130 Milton Dr.</u>	Method of Lat/Long (circle one): <u>Conventional Survey</u>		
<u>Collierville Tn. 38017</u>	USGS quad, <u>Hand-held GPS</u> , Survey-grade GPS		
City State Zip Code	<u>NW 1/4 SE 1/4 Sec 28 Twn 27N Rng 3W</u>		
Telephone No. <u>(901) 461-6095</u>	Distance <u>1</u> Miles	Direction <u>E</u>	Nearest Town <u>of Clarksdale</u>

Well Data

Purpose of Well (circle one) Home Industrial Public Supply Irrigation Fish Culture Other: _____

Date well drilling started: 6-12-09 Date well drilling completed: 6-12-09

If flowing, method of flow regulation: Valve _____ Other (describe) _____

Static Water Level: 26 feet above or below (circle one) land surface Date measured: 6-19-09

Method of Measurement (circle one) steel tape electric tape air line other: _____

Hole depth: 117 Well depth: 117 Well grouted to a depth of 10 feet

Type of grout (circle one): Cement Bentonite Mix

Casing length: 77 feet Casing diameter: 16 inches Type of casing: PVC

Screen length: 40 feet Screen diameter: 16 inches Type of screen: PVC

Screen slot size: .050 inches Setting depth: From see back feet to _____ feet

Type of completion (circle all applicable): Gravel packed Underreamed Telescoped Open hole Natural Development
 Other (describe): _____

Top of lap pipe or reduction in casing: _____ feet. If telescoped or more than one screen, describe on back of page

Logs run (circle all applicable): No log run Electric Gamma Ray Density Sonic Neutron Other: _____

Name of organization running log(s): _____

I certify that the well was drilled, constructed, and completed in accordance with all applicable requirements of the Mississippi Department of Environmental Quality and/or the Mississippi Department of Health regulations and state laws.

Irrigation Equipment Inc.
John P. Chism 0439

Print Name of Water Well Contractor and License No. _____

John P. Chism
 Signature of Water Well Contractor

RECEIVED
 JUN 25 2009
 BY OLMP

If well telescopes please sketch below and show depths.

K98

Ground Level

Description of Formations Encountered	From	To
Clay	0	22
Fine Sand	23	38
Fine Sand + Gravel	39	54
Medium Sand + Gravel	55	88
Fine Sand	89	91
Medium Sand + Gravel	92	117
Screen .050		
(65-84) 20'		
(98-117) 20'		

Blanka
13'

If more than one screen, show location of each on sketch

Sketch the property layout and include the following: 1) the well location; 2) any permanent structures on the property that may aid in locating the well; 3) any roads, power lines, or other items that may aid in locating the property and the well; 4) indicate direction.

Landowner Name: Yanley Farm Partners

John
Signature of Water Well Contractor

RECEIVED
JUN 25 2009
BY OLIVER

STATE WELL REPORT

Part 2

Pump Installer's Completion Report
 Mississippi Department of Environmental Quality
 Office of Land and Water Resources
 P.O. Box 10631
 Jackson, MS 39289-0631
 (601)961-5210
 (601)354-6938 (fax)

County: Coahoma
 Permit #: _____
 Irrigation Equipment
 Dealer: _____
 Date completed: 6-12-09

For Office Use Only:

Aquifer: _____
 Well #: K98
 Elevation: _____

This report should be prepared by the pump installer in detail and filed with the Department within 30 days of the installation of pump.

Well Owner Information	Well Location
Owner Name: <u>Yanley Farm Partners</u>	Latitude: <u>34° 11' 30"</u> Longitude: <u>90° 30' 50"</u>
Mailing Address: <u>130 Milton Dr.</u>	Method of Lat/Long (circle one): <u>Conventional Survey</u>
<u>Collierville, Tn. 38017</u>	USGS quad, Hand-held GPS, Survey-grade GPS.
City State Zip Code	<u>SE ¼ SW ¼ Sec 21 Twn 27N Rng 3W</u>
Telephone No. () _____	Distance Direction Nearest Town
	<u>1</u> Miles <u>E</u> of <u>Clarksdale</u>


Pump Type Circle one	Power Type Circle one
Air Lift Jet Submersible	<u>Diesel Engine</u> Gasoline Engine Natural Gas
Bucket Piston <u>Turbine</u>	Electric Motor Hand Tractor PTO
Centrifugal Rotary Flowing Well	Windmill Other (specify): _____
Other (specify): _____	Horse Power Rating of Motor: <u>60</u>
Date Pump Installed: <u>6-19-09</u>	Setting Depth: <u>70</u> feet
Rated Pump Capacity: <u>2800 ±</u> Gallons Per Minute	Number of Stages: <u>1</u>

Pump Test Data	Method of Measuring Water Level Circle one
Date Well Tested: _____	Air Line Electric Measuring Line Steel Tape
Static Water Level (A): _____ Feet Below Land Surface	Other (specify): _____
Pumping Water Level (B): _____ Feet Below Land Surface	For flowing well, measured shut in head: _____ feet
Drawdown [(B) - (A)]: _____ Feet Below Land Surface	Well yielded _____ GPM with a drawdown of
Test Pumping Rate: _____ Gallons Per Minute	_____ feet after _____ hours of pumping
Duration of Pump Test (minimum 4 hours): _____ hours	

I HEREBY CERTIFY that the above statements are true to the best of my knowledge.

John P. Chism 0439
 Print Name of Pump Installer and License No. (if applicable) Signature of Pump Installer

RECEIVED
 JUN 19 2009
 BY CLWA

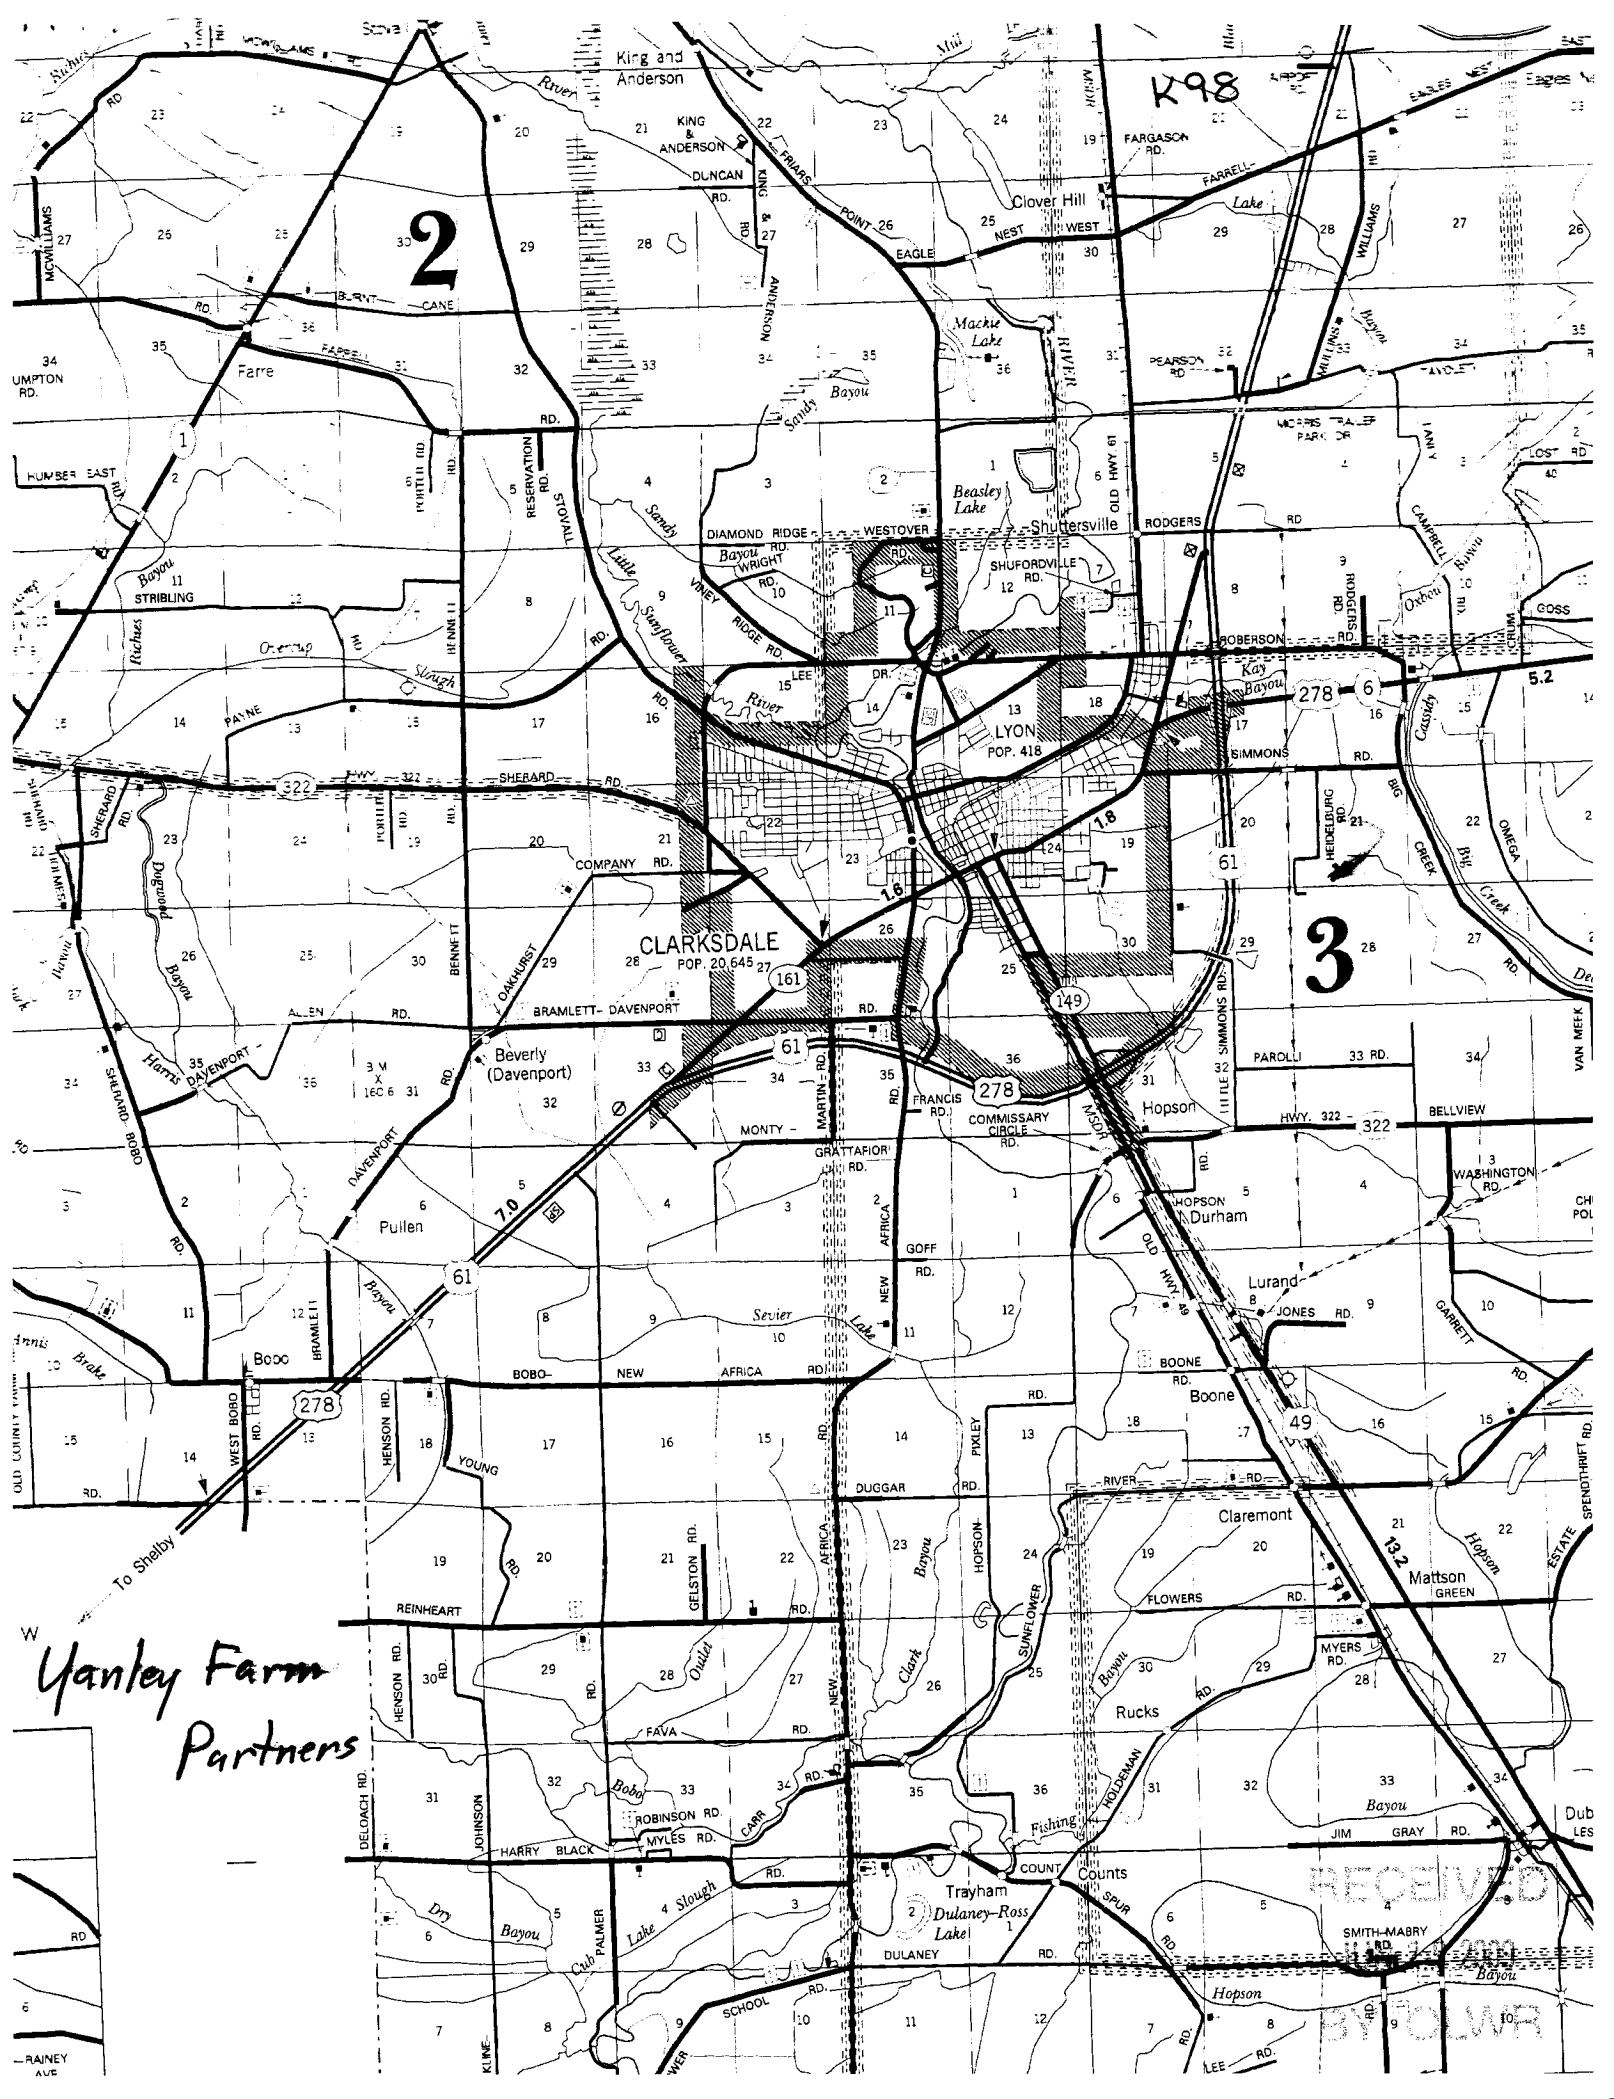

K98

2

3

CLARKSDALE
POP. 20,645

LYON
POP. 418

Yanley Farm
Partners

RECEIVED
BY TOWNSHIP