

State Well Report

Part I - Driller's Log

Mississippi Department of Environmental Quality
 Office of Land and Water Resources
 P.O. Box 2307
 Jackson, MS 39225
 (601)961- 5210
 (601)961- 5228 (fax)

County: Cochran
 Permit # MS 600-16681
 Driller Michael Wells
 Date drilling completed 12-11-09

For Office Use Only:
 Aquifer K 102
 Well # _____
 I. S. Elevation: _____
 E-log #. _____

State Law requires that this report be prepared by the license holder responsible for the work and filed with the Department at the above address within 30 days of completion of drilling of the well or borehole.

Information on Well Owner (Landowner if borehole is not for a water well)	Well or Borehole Location
Owner Name: <u>Green Acres Water Assoc.</u>	Latitude: <u>N34° 13' 20.5"</u> Longitude: <u>W90° 30' 26.2"</u>
Mailing Address: <u>P.O. Box 13</u>	Method of Lat/Long (circle one): <u>Conventional Survey</u>
<u>Marcks</u> <u>MS</u> <u>38646</u>	USGS quad, Hand-held GPS, Survey-grade GPS
City State Zip Code	<u>SE 1/4 Sec 9</u> Twn <u>27N</u> Rng <u>3W</u>
Telephone No. <u>(662) 563-8224</u>	Distance Direction Nearest Town <u>2</u> Miles <u>East</u> of <u>Cyon</u>

Well / Borehole Data

Date drilling started: 11-5-09 Date drilling completed: 12-11-09 Hole depth: 1154' Hole diameter: 22"

Location of the source of any surface water used for drilling: Green Acres Water System
 Method of dosing and volume of Chlorine used in drilling and development: Chlorinated Water

Logs run (circle all applicable): No log run Electric Gamma Ray Density Sonic Neutron Other: _____
 Name of organization running log(s): MS Office of Geology

Purpose of borehole (check one): Water Well Geotechnical/Geological Investigation _____ Ground Source Heat Pump _____
 Seismic Survey _____ Other (describe) _____
If drilling is not related to water well construction, skip the remainder of this block

Purpose of Well (check one): Home _____ Industrial _____ Public Supply Irrigation _____ Fish Culture _____ Other: _____

If a flowing well, method of flow regulation: Valve _____ Other (describe) NA

Static Water Level: 25 feet above or below (circle one) land surface Date measured: 12-11-09

Method of Measurement (circle one) steel tape electric tape air line other: _____

Well depth: 1150 Well grouted to a depth of 1105 feet Type of grout (circle one): Neat Cement Bentonite Mix

Casing length: 1105 feet Casing diameter: 12 inches Type of casing: Steel

Screen length: 40 feet Screen diameter: 8 inches Type of screen: Stainless Steel

Screen slot size: .020 inches Setting depth: From 1110 feet to 1150 feet

Type of completion (circle all applicable): Gravel packed Underreamed Telescoped Open hole Natural Development
 Other (describe): _____


Top of tap pipe or reduction in casing: 1025 feet. *If telescoped or more than one screen, describe on next page*

R103

The sketch below only required for water wells

If well telescopes, show depths on sketch.

Ground Level →

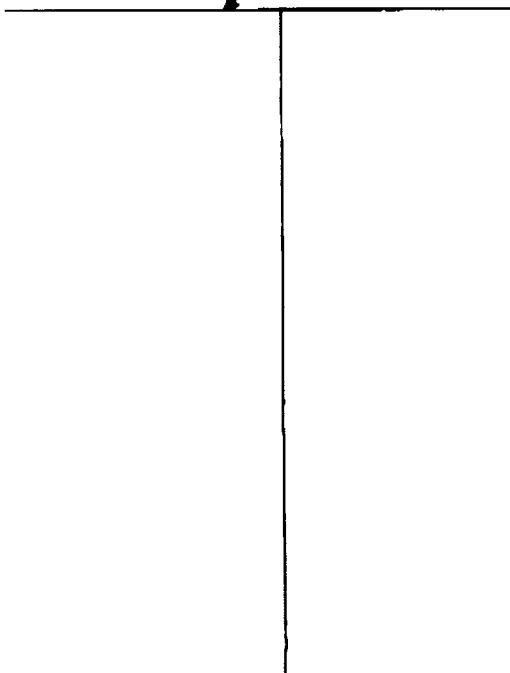


Description of formations encountered must be provided for all wells and boreholes, unless specifically exempted by regulations

Description of Formations Encountered	From (depth)	To (depth)
Fine Sand	Ground Level	60
Medium Sand	60	101
Coarse Sand & Gravel	101	148
Fine Sand	148	201
Clay & Fine Sand	201	348
Fine Sand & Shale	348	460
Shale & Fine Sand	460	530
Shale & Fine Sand	530	732
Clay	732	752
Sandy Clay	752	827
Clay w/ Sand streaks	827	1033
Clay w/ Sand	1033	1044
Sand	1044	1120
Sand w/ Clay streaks	1120	1155

If more than one screen, show location of each on sketch

Sketch the property layout and include the following: 1) the well location; 2) any permanent structures on the property that may aid in locating the well; 3) any roads, power lines, or other items that may aid in locating the property and the well; 4) a north arrow.

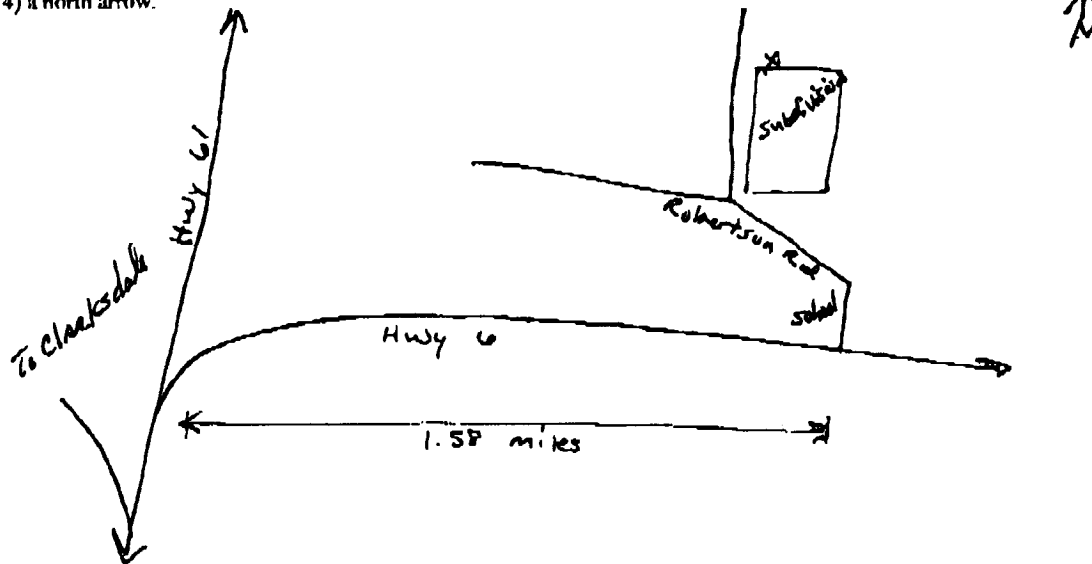

Landowner Name: Green Acres W.A.

Form: OLWR-SWR-1A (04/08)

I certify that the well/borehole was drilled, constructed, and completed in accordance with all applicable requirements of the Mississippi Department of Environmental Quality and the Mississippi Department of Health regulations, if applicable, and state laws.

Clayton Miller 0-703

Clayton Miller

Print Name of Responsible Licensee and License No.

Date

Signature of Licensee

STATE WELL REPORT

Part 2

Pump Installer's Completion Report
 Mississippi Department of Environmental Quality
 Office of Land and Water Resources
 P. O. Box 2309
 Jackson, MS 39225
 (601)961-5210
 (601)961-5228 (Fax)

County Cook DMA
 Permit #. MS-610-166E1
 Driller: J. DeWayne Griffin
 Date completed: 12-16-09
 Copy information from block on Part 1

For Office Use Only:
 Aquifer: _____
 Well # K102
 Elevation: _____

This part of the report must be completed by a licensed water well contractor or a licensed pump installer. A copy of Part 1 of the report must be attached and both parts filed with the Department at the above address within 30 days of well completion.

Well Owner Information	Well Location
Owner Name: <u>Green Acres Water Assoc.</u>	Latitude: <u>N34°13'20.5"</u> Longitude: <u>W90°30'26.2"</u>
Mailing Address: <u>P.O. Box 13</u>	Method of Lat/Long (check one): Conventional Survey _____, USGS quad _____, Hand-held GPS <input checked="" type="checkbox"/> , Survey-grade GPS _____
<u>Marles MS 38646</u> City State Zip Code	<u>SE 1/4 SE 1/4 Sec 9 T 27N R 3W</u>
Telephone No. <u>(662) 563-8224</u>	Distance Direction Nearest Town <u>2 Miles East of Lyon</u>

Pump Type Circle one	Power Type Circle one
Air Lift <input type="checkbox"/> Jet <input type="checkbox"/> Submersible <input checked="" type="checkbox"/>	Diesel Engine <input type="checkbox"/> Gasoline Engine <input type="checkbox"/> Natural Gas <input type="checkbox"/>
Bucket <input type="checkbox"/> Piston <input type="checkbox"/> Turbine <input type="checkbox"/>	Electric Motor <input checked="" type="checkbox"/> Hand <input type="checkbox"/> Tractor PTO <input type="checkbox"/>
Centrifugal <input type="checkbox"/> Rotary <input type="checkbox"/> Flowing Well <input type="checkbox"/>	Windmill <input type="checkbox"/> Other (specify): _____
Other (specify): _____	Horse Power Rating of Motor: <u>20</u>
Date Pump Installed: <u>12-16-09</u>	Setting Depth: <u>105</u> feet
Rated Pump Capacity: <u>200</u> Gallons Per Minute	Number of Stages: <u>N/A</u>

Pump Test Data	Method of Measuring Water Level Circle one
Date Well Tested: <u>12-28-09</u>	Air Line <input type="checkbox"/> Electric Measuring Unit <input checked="" type="checkbox"/> Steel Tape <input type="checkbox"/>
Static Water Level (A): <u>25</u> Feet Below Land Surface	Other (specify): _____
Pumping Water Level (B): <u>42.3</u> Feet Below Land Surface	For flowing well, measured shut in head: <u>N/A</u> feet
Drawdown [(B) - (A)]: <u>17.3</u> Feet Below Land Surface	Well yielded <u>200</u> GPM with a drawdown of
Test Pumping Rate: <u>200</u> Gallons Per Minute	<u>17.3</u> feet after <u>24</u> hours of pumping
Duration of Pump Test (minimum 4 hours): <u>24</u> hours	

I HEREBY CERTIFY that the above statements are true to the best of my knowledge.

Clayton Miller 0-703
 Print Name of Pump Installer and License No. (if applicable) Signature of Pump Installer