

State Well Report

Part 1

Mississippi Department of Environmental Quality
Office of Land and Water Resources
P.O. Box 10631
Jackson, MS 39289-0631
(601)961-5210
(601)354-6938 (fax)

For Office Use Only:

Aquifer: _____
Well #: K-106
L. S. Elevation: _____
E-log #: _____

County: Coahoma
Permit #: _____
Driller: Willie L. Bryant
Date drilling completed: 10-8-05

State Law requires that this report be prepared by the driller in detail and filed with the Department within 30 days of completion of drilling of the well.

Well Owner Information	Well Location
Owner Name: <u>Jessie Tolivar</u>	Latitude: <u>34° 09' 22" N</u> Longitude: <u>090° 32' 00" W</u>
Mailing Address: <u>1578 Alan Dr.</u>	Method of Lat/Long (circle one): <u>Hand-held GPS</u> Conventional Survey
<u>Clarksdale</u> <u>MS</u> <u>38614</u>	USGS quad: <u>SE 1/4 SW 1/4 Sec 32 Twn 27 N Rng 3 W</u>
City State Zip Code	
Telephone No. <u>(662) 627-4655</u>	Distance <u>1 1/4</u> Miles Direction <u>East</u> of Nearest Town <u>Hopson</u>

Well Data

Purpose of Well (circle one): Home Industrial Public Supply Irrigation Fish Culture Other: _____

Date well drilling started: 10-8-05 Date well drilling completed: 10-8-05

If flowing, method of flow regulation: Valve _____ Other (describe) _____

Static Water Level: 31' feet above or below (circle one) land surface Date measured: 10-8-05

Method of Measurement (circle one): steel tape electric tape air line other: Rope & weight

Hole depth: 115' Well depth: 112' Well grouted to a depth of 10 feet

Type of grout (circle one): Cement Bentonite Mix

Casing length: 92' feet Casing diameter: 4" inches Type of casing: PVC 160

Screen length: 20' feet Screen diameter: 4" inches Type of screen: PVC SCH 40

Screen slot size: 0/10 inches Setting depth: From 92' feet to 112' feet

Type of completion (circle all applicable): Gravel packed Underreamed Telescoped Open hole Natural Development

Other (describe): _____

Top of lap pipe or reduction in casing: 0 feet. If telescoped or more than one screen, describe on back of page

Logs run (circle all applicable): No log run Electric Gamma Ray Density Sonic Neutron Other: _____

Name of organization running log(s): _____

I certify that the well was drilled, constructed, and completed in accordance with all applicable requirements of the Mississippi Department of Environmental Quality and/or the Mississippi Department of Health regulations and state laws.


Willie L. Bryant 0-639 Willie L. Bryant
Print Name of Water Well Contractor and License No. Signature of Water Well Contractor

Pump will be set by Landowner

RECEIVED
NOV 07 2005
BY: OLWR


If well telescopes please sketch below and show depths.

Ground Level

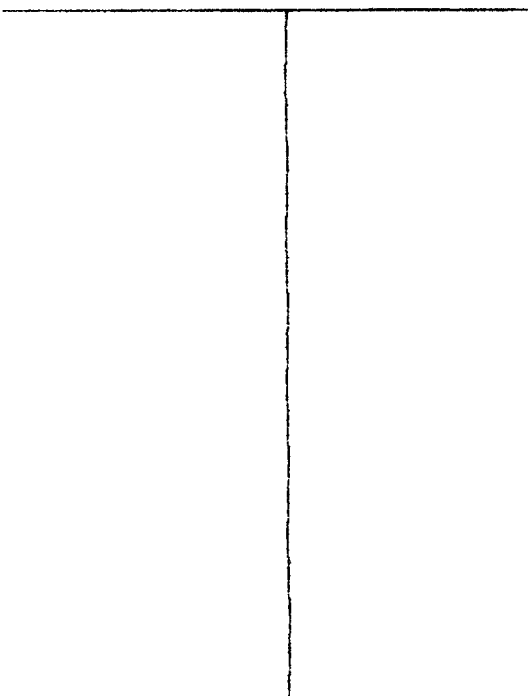

Description of Formations Encountered	From	To
Top Soil & Clay	0	20
Clay	20	40
Clay	40	60
Clay & Med. Sand	60	80
Coarse Sand	80	100
Coarse Sand & gravel	100	112

If more than one screen, show location of each on sketch

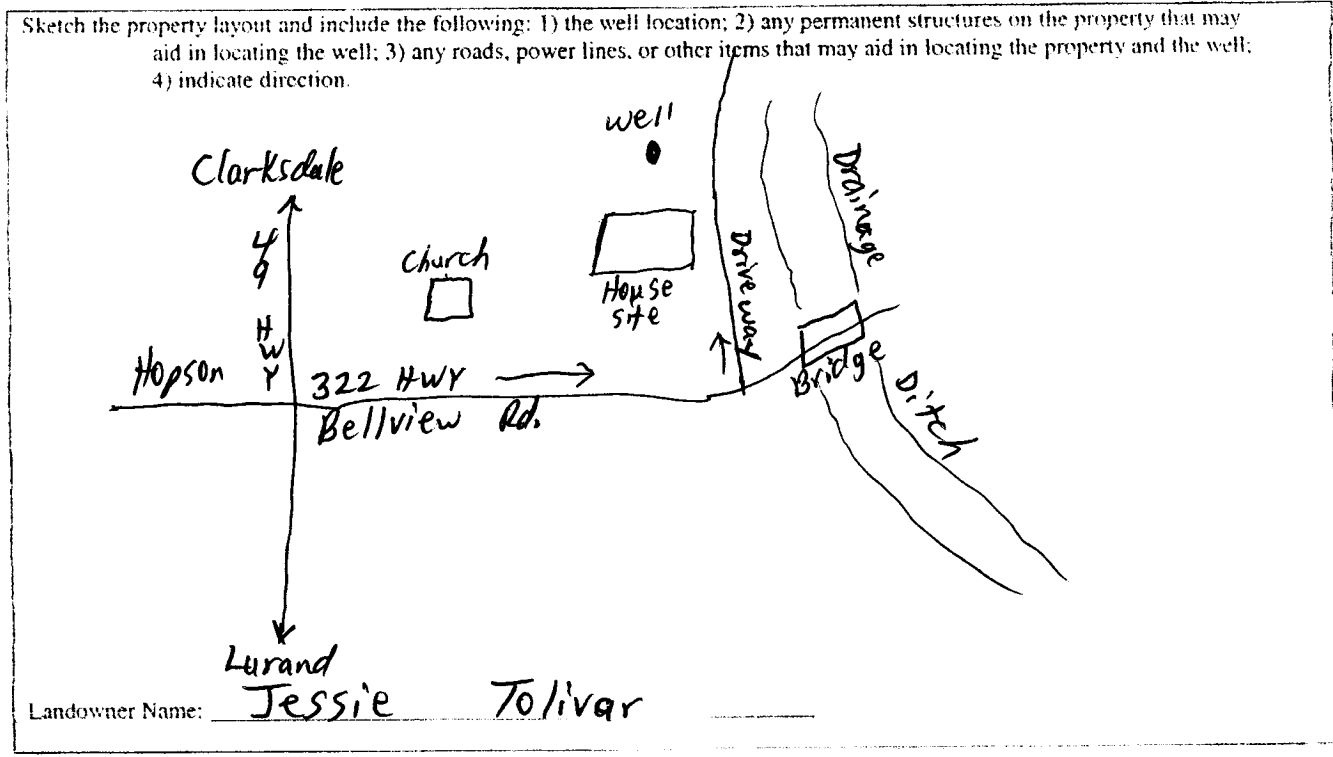

Willie L. Bryant
 Signature of Water Well Contractor

RECEIVED
 NOV 07 2005
 BY: OLWR