

COAHOMA MISSISSIPPI BOARD OF WATER COMMISSIONERS

L 6

6-17-63


WATER WELL DRILLERS LOG

**CODED**

Date: 6-17, 1963, Driller: Five County Farmers county Coahoma  
(Name)

(1) Owner of Land:	Description & Color of Materials Sand, Clay, Red Clay, Shell, etc.	Thick- ness Feet	Depth Feet
<u>Aeddy Carr</u> (Name)	<u>Gumbo</u>	<u>0 1/2</u>	<u>1 1/2</u>
<u>Clarksdale Miss</u> (Address)	<u>FINE SAND + GUMB.</u>	<u>1 1/2</u>	<u>27 1/2</u>
(2) Location: <u>1/4</u> , <u>1/4</u> , Sec. <u>23</u> T <u>26</u> R <u>4</u>	<u>BLUE MUD</u>	<u>27 1/2</u>	<u>50</u>
<u>5</u> miles <u>South</u> of <u>Clarksdale</u> (distance) (direction) (Nearest Town)	<u>SAND, ROCK, +</u>		
<u>5</u> miles <u>South</u> of <u>Clarksdale</u> (distance) (direction) (Nearest Town)	<u>Red rock</u>	<u>50</u>	<u>110</u>
(3) Topography: _____ (Hilly) (Flat) (Level)			
(4) Purpose of Well: <u>Irrigation</u> (Domestic, Irrigation, Municipal, Industrial, Other)			

**CODED**

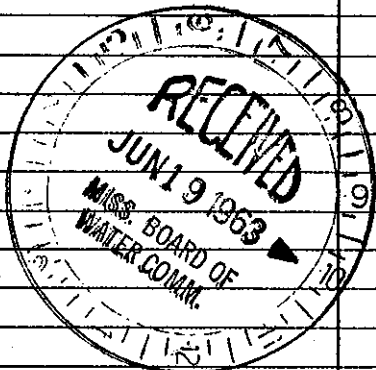

Information upon completion of well:

(1) Diameter 14 inches.

(2) Total Depth 110 feet.

(3) Water Level 21' feet below top of ground.

(4) Cased to 60', Size 14"

(5) Screen: Size 48', Length 16

(6) Were any formations sealed against pollution?  
\_\_\_\_\_ yes, no.

If YES depth of formation \_\_\_\_\_

Why \_\_\_\_\_

Drillers Remarks: AD

(Use Back Side)

Well No.

Mail this copy to Board of Water Commissioners 429 Miss. St. Jackson, Miss