

COAHOMA MISSISSIPPI BOARD OF WATER COMMISSIONERS

L 13

GW-5925 NW/NE, Sec. 26, T26N, R44W

**CODED**

5-21-64

WATER WELL DRILLERS LOG

Elev. 156

Date: 5-21, 1964, Driller: Five County Farmers County COAHOMA  
(Name 1755N)

(1) Owner of Land:	Description & Color of Materials Sand, Clay, Red Clay, Shell, etc.	Thick- ness Feet	Depth Feet
Name: <u>Audrey Carr</u>	<u>Brushed top Soil + Sand</u>	<u>14'</u>	<u>14</u>
(Address): <u>Clarksdale Miss</u>	<u>Fine Sand</u>	<u>14'</u>	<u>28</u>
Location: <u>NW 1/4, NE 1/4, Sec. 26 T26R4</u>	<u>Sand</u>	<u>26'</u>	<u>54</u>
5 miles <u>South</u> of <u>Clarksdale</u>	<u>Blue mud.</u>	<u>12'</u>	<u>66</u>
(distance) (direction) (Nearest Town)	<u>Sand + gravel</u>		
(3) Topography: <u>FLAT</u>	<u>including large</u>		
(Hilly) (Flat) (Level)	<u>rock, small rock</u>		
(4) Purpose of Well: <u>Irrigation</u>	<u>and pea rock</u>	<u>27'</u>	<u>103</u>
(Domestic Irrigation Municipal, Industrial, Other)	<u>Screen setting on</u>		
	<u>SOLIO ROCK</u>		

Information upon completion of well:

- (1) Diameter 14 inches.
- (2) Total Depth 103 feet.
- (3) Water Level 21 feet below top of ground.
- (4) Cased to 65, Size 14
- (5) Screen: Size 14, Length 48
- (6) Were any formations sealed against pollution?  
\_\_\_\_\_ yes, \_\_\_\_\_ no.


If YES depth of formation \_\_\_\_\_

Why \_\_\_\_\_

Drillers Remarks: \_\_\_\_\_

*[Handwritten signature]*

**CODED**

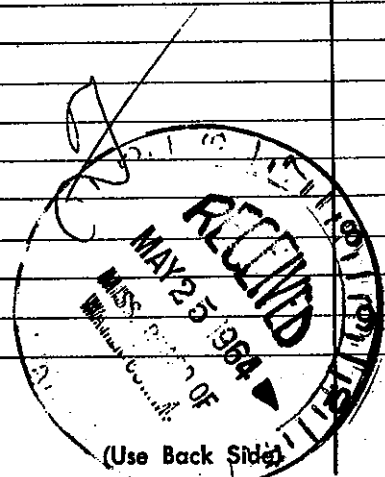

Well No. \_\_\_\_\_

Mail this copy to Board of Water Commissioners 429 Miss. St. Jackson, Miss.