


LOANOMA MISSISSIPPI BOARD OF WATER COMMISSIONERS

5L16  
8-16-65

WATER WELL DRILLERS LOG

Date: 8/16, 1965, Driller: Baley Drilling Co County: Washington  
(Name)

	Description & Color of Materials Sand, Clay, Red Clay, Shell, etc.	Thick- ness Feet	Depth Feet
(1) Owner of Land: <u>J. T. Fox</u> (Name) <u>Clarksdale</u> (Address)	Clay		18
	Sand		50
	Gravel		70
(2) Location: <u>1/4</u> , <u>1/4</u> , Sec. <u>11</u> T <u>26</u> R <u>4</u> , <u>2</u> miles <u>S</u> of <u>Clarksdale</u> (distance) (direction) (Nearest Town)	Mud		246
	Sand		307
	Mud		389
(3) Topography: <u>Flat</u> (Hilly) (Flat) (Level)	Sand		420
(4) Purpose of Well: <u>Domestic</u> (Domestic Irrigation Municipal, Industrial, Other)	Mud		611
	Sand		657
	Mud & rocks		1178
	Sand		1191
	Mud		1231
	Sand		1267
Information upon completion of well:			
(1) Diameter <u>4x3x2 1/2</u> inches.			
(2) Total Depth <u>1267</u> feet.			
(3) Water Level <u>1 1/2 ft above</u> feet below top of ground.			
(4) Cased to <u>all way</u> Size <u>4x3x2 1/2</u>			
(5) Screen: Size <u>2 1/2</u> , Length <u>30 ft</u>			
(6) Were any formations sealed against pollution? yes, <u>X</u> no.			
If YES depth of formation _____			
Why _____			
Drillers Remarks: _____			
_____			
_____			
_____			

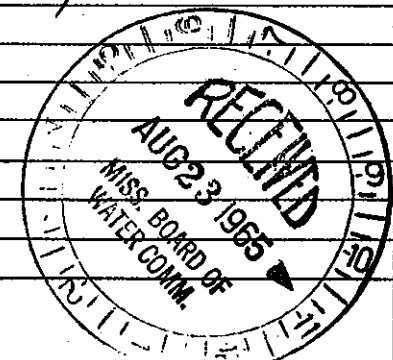

(Use Back Side)

Well No.

Mail this copy to Board of Water Commissioners 429 Miss. St. Jackson, Miss.