

COAHOMA MISSISSIPPI BOARD OF WATER COMMISSIONERS

OL 17


9-21-62

WATER WELL DRILLERS LOG

Date: 9/21, 1962, Driller: Bailey Drilling Co. County Coahoma
(Name)

(1) Owner of Land:	Description & Color of Materials Sand, Clay, Red Clay, Shell, etc.	Thick- ness Feet	Depth Feet
<u>John Francis</u> <small>(Name)</small>	<u>Clay</u>	<u>30</u>	<u>30</u>
<u>Clarksdale</u> <small>(Address)</small>	<u>Sand</u>		<u>90</u>
(2) Location: <u>1/4</u> , <u>1/4</u> , Sec. <u>2</u> T <u>26</u> R <u>4</u>	<u>Gravel</u>		<u>150</u>
<u>3</u> miles <u>SW</u> of <u>Clarksdale</u>	<u>Sand</u>		<u>380</u>
<small>(distance) (direction) (Nearest Town)</small>	<u>Mud</u>		<u>400</u>
(3) Topography: <u>Flat</u>	<u>Sand</u>		<u>445</u>
<small>(Hilly) (Plain) (Level)</small>	<u>Mud & rocks</u>		<u>667</u>
(4) Purpose of Well: <u>Domestic</u>	<u>Sand</u>		<u>687</u>
<small>(Domestic Irrigation Municipal, Industrial, Other)</small>	<u>Mud & rocks</u>		<u>1080</u>
Information upon completion of well:	<u>Sand</u>		<u>1123</u>
(1) Diameter <u>4x3</u> inches.	<u>Mud</u>		<u>1186</u>
(2) Total Depth <u>1253</u> feet.	<u>Sand</u>		<u>1214</u>
(3) Water Level <u>5</u> feet below top of ground.	<u>Mud</u>		<u>1216</u>
(4) Cased to <u>all way</u> Size <u>4x3</u>	<u>Sand</u>		<u>1253</u>
(5) Screen: Size <u>2</u> , Length <u>30</u>			
(6) Were any formations sealed against pollution? <u>no</u>			
If YES depth of formation _____			
Why _____			
Drillers Remarks: _____			

Call

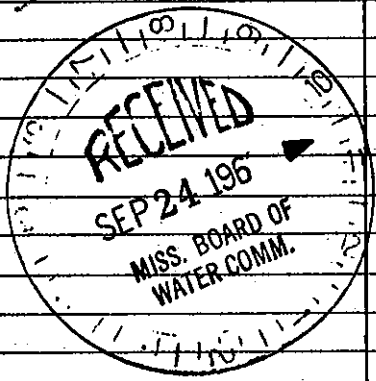

(Use Back Side)

Well No.

Mail this copy to Board of Water Commissioners 429 Miss. St. Jackson, Miss.