

COAHOMA MISSISSIPPI BOARD OF WATER COMMISSIONERS

L 18

5-12-65

WATER WELL DRILLERS LOG

CODED

Date: 5-12, 1965, Driller: FIVE COUNTY FARMERS CO. COAHOMA
(Name)

(1) Owner of Land: Massey Altus
(Name)
(Andy Carr)
Clarksdale Miss
(Address)

(2) Location: 1/4, 1/4, Sec. 35, T26R9,
7 miles South SE of Clarksdale
(distance) (direction) (Nearest Town)

(3) Topography: Flat
(Hilly) (Flat) (Level)

(4) Purpose of Well: Irrigation
(Domestic Irrigation, Municipal, Industrial, Other)

Description & Color of Materials Sand, Clay, Red Clay, Shell, etc.	Thick- ness Feet	Depth Feet
Bucket - a little sand	21'	21'
Bucket - some fine sand		
and rock	6 1/2'	27 1/2'
fine sand	13'	40 1/2'
Coarse sand	6 1/2'	47'
Coarse sand some charcoal	6 1/2'	53 1/2'
Coarse sand gravel		
+ Rock	26'	79 1/2'
Coarse sand + gravel with		
about a foot of clay	6 1/2'	86'
sand, coarse gravel		
and large rock	3 1/2'	118 1/2'
Bottom 10' practically		
all rock - good		
formation		

Information upon completion of well:

(1) Diameter 14 inches.

(2) Total Depth 114 feet.

(3) Water Level 19' 6" feet below top of ground.

(4) Cased to 66' 8", Size 14"


(5) Screen: Size 14", Length 48'

(6) Were any formations sealed against pollution?
_____ yes, _____ no.

If YES depth of formation _____

Why _____

Drillers Remarks: _____

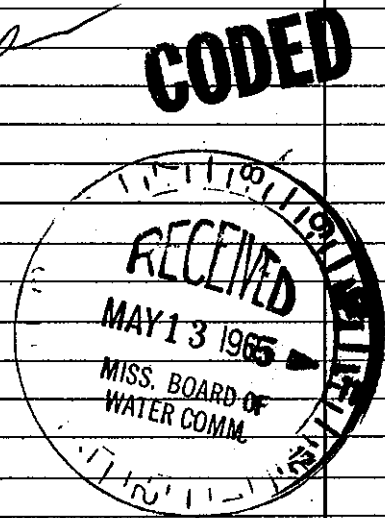

(Use Back Side)

Well No.

Mail this copy to Board of Water Commissioners 429 Miss. St. Jackson, Miss