

COAHOMA

MISSISSIPPI BOARD OF WATER COMMISSIONERS

L 23

6-5-57

WATER WELL DRILLERS LOG

**CODED**

280

Date: June 5, 19 57, Driller: Layne-Central Company County Coahoma

(Name)

		Description & Color of Materials Sand, Clay, Red Clay, Shell, etc.	Thick- ness Feet	Depth Feet
(1) Owner of Land: <u>Leon Brawlett</u> (Name)		<u>Clay</u>	<u>13</u>	<u>13</u>
<u>Clarksdale, Mississippi</u> (Address)		<u>Coarse sand</u>	<u>19</u>	<u>32</u>
<u>56 26 4</u> <u>20 27 28 29</u>		<u>Coarse brown sand</u>	<u>10</u>	<u>42</u>
(2) Location: <u>1/4</u> , <u>1/4</u> , Sec. <u>30 31 32 T 27 R 4</u>		<u>Coarse sand</u>	<u>10</u>	<u>52</u>
<u>3</u> miles <u>south</u> of <u>Clarksdale</u> (distance) (direction) (Nearest Town)		<u>Coarse sand</u>	<u>10</u>	<u>62</u>
(3) Topography: <u>flat</u> (Hilly) (Flat) (Level)		<u>Coarse sand &amp; pea gravel</u>	<u>20</u>	<u>82</u>
(4) Purpose of Well: <u>irrigation</u> (Domestic Irrigation Municipal, Industrial, Other)		<u>Sand &amp; pea gravel</u>	<u>30</u>	<u>112</u>
		<u>Sand &amp; big gravel</u>	<u>5</u>	<u>117</u>

Information upon completion of well:

- (1) Diameter 18x16 inches.
- (2) Total Depth 117 feet.
- (3) Water Level 19 feet below top of ground.
- (4) Cased to 64', Size 18",  
2' swage
- (5) Screen: Size 16", Length 50'
- (6) Were any formations sealed against pollution?  
no yes, no no.

If YES depth of formation \_\_\_\_\_


Why \_\_\_\_\_

Drillers Remarks: \_\_\_\_\_

3575 GPM

engine drive

**CODED**

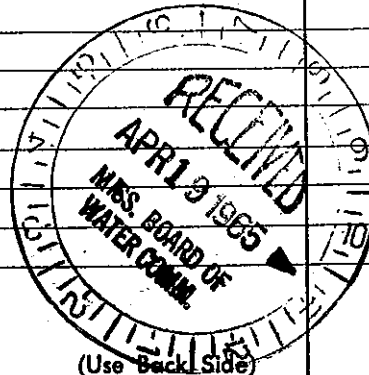

Well No.

Mail this copy to Board of Water Commissioners 429 Miss. St. Jackson, Miss.