

Coaloma MISSISSIPPI BOARD OF WATER COMMISSIONERS

L 24
6-66

WATER WELL DRILLERS LOG

CODED

Date: 6-21, 1966, Driller: Five County Farmers Assn County Coaloma
(Name)

(1) Owner of Land: B. J. McLauren
(Name)
Clarksdale Miss
(Address) 31 26 9
6 miles East of Alligator
(distance) (direction) (Nearest Town)

(2) Location: 1/4, 1/4, Sec. 26 T26R3

(3) Topography: Flat
(Hilly) (Flat) (Level)

(4) Purpose of Well: Irrigation
(Domestic Irrigation, Municipal, Industrial, Other)

Description & Color of Materials Sand, Clay, Red Clay, Shell, etc.	Thick- ness Feet	Depth Feet
Clay (Purkshot)	27	27
fine sand, trace of clay	13	40
fine sand & purkshot	6 1/2	46 1/2
Coarse sand, trace clay	32 1/2	79
Coarse sand & gravel	13	92
Coarse sand & large rock	12	104
Clay	14	118

CODED

Information upon completion of well:

(1) Diameter 14 inches.

(2) Total Depth 105' 3" feet.

(3) Water Level 18' feet below top of ground.

(4) Cased to 62' 3", Size 14


(5) Screen: Size 14, Length 48'

(6) Were any formations sealed against pollution?
_____ yes, _____ no.

If YES depth of formation _____

Why _____

Drillers Remarks: _____

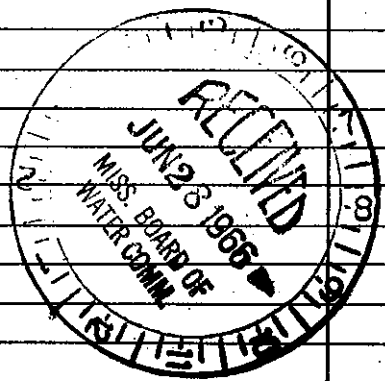

Well No.

(Use Back Side)

Mail this copy to Board of Water Commissioners 429 Miss. St. Jackson, Miss.