

COAHOMA MISSISSIPPI BOARD OF WATER COMMISSIONERS

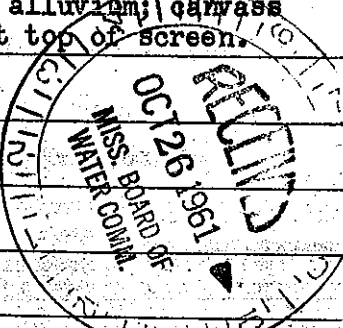
L 26  
10-10-61

WATER WELL DRILLERS LOG

**CODED** 12/2/85  
- 300

Date: Oct. 10, 1961, Driller: Layne-Central Company, County Coahoma

(Name)

(1) Owner of Land: <u>W. E. Young</u> (Name)	Description & Color of Materials Sand, Clay, Red Clay, Shell, etc.	Thick- ness Feet	Depth Feet
<u>Clarksdale, Mississippi</u> (Address)	Clay	19	19
(2) Location: <u>1/4, 1/4, Sec. 17 T. 26N. R. 4W</u>	Fine sand	7	26
<u>near</u> of <u>Bobo</u> (distance) (direction) (Nearest Town)	Blue clay	19	45
(3) Topography: <u>flat</u> (Hilly) (Flat) (Level)	Fine sand	27	72
(4) Purpose of Well: <u>domestic</u> (Domestic Irrigation Municipal, Industrial, Other)	Coarse sand & pea gravel	58	130
Information upon completion of well:	Clay	20	150
(1) Diameter <u>6x3</u> inches.	Sand	58	208
(2) Total Depth <u>1299</u> feet.	Sand & clay streaks	167	375
(3) Water Level <u>flowing</u> feet below top of ground.	Clay	15	390
(4) Cased to <u>1122'</u> Size <u>3"</u> <u>2'</u> lead seal and swedge	Sand & clay streaks	90	480
(5) Screen: Size <u>3"</u> , Length <u>30'</u> <u>3'</u> B.P.V.	Clay	161	641
(6) Were any formations sealed against pollution? <u>X</u> yes, <u>      </u> no.	Rock	1	642
If YES depth of formation <u>lead seal at</u> <u>bottom of alluvium; canvas</u>	Clay & sandy clay strks.	60	702
Why <u>packer at top of screen.</u>	Sandy shale	73	775
Drillers Remarks:	Clay & hard shale	18	793
	Rock	1	794
	Shale	14	808
	Rock	1	809
	Clay & shale	36	845
	Rock	1	846
	Hard shale	40	886
	Rock	1	887
	Hard shale	26	913
	Rock	1	914
	Shale & sand strks.	26	940
	Shale & clay	64	1004
	Shale & sandy shale strks	46	1050
	Hard shale	25	1075
	Sandy shale & Hard shale strks.	61	1136
	Sandy shale	29	1165
	Shale	33	1198
	(Over)		Well No.

(Use Back Side)

Mail this copy to Board of Water Commissioners 429 Miss. St. Jackson. Miss