

COAHOMA MISSISSIPPI BOARD OF WATER COMMISSIONERS

L 28

5-24-63

WATER WELL DRILLERS LOG

CODED

Date: 5/24, 1963, Driller: Fine County Farm County Coahoma
(Name)

(1) Owner of Land:	Description & Color of Materials Sand, Clay, Red Clay, Shell, etc.	Thick- ness Feet	Depth Feet
<u>Andy Carr</u> <small>(Name)</small>	<u>Clay</u>	<u>20</u>	<u>20</u>
<u>Clarksdale, Miss</u> <small>(Address)</small>	<u>7 feet Sand</u>	<u>15</u>	<u>35</u>
(2) Location: <u>1/4</u> , <u>1/4</u> , Sec. <u>26</u> T <u>26</u> R <u>4E</u>	<u>Clay</u>	<u>14</u>	<u>49</u>
<u>5</u> miles <u>South</u> of <u>Clarksdale</u> <small>(distance) (direction) (Nearest Town)</small>	<u>Coarse Sand</u>	<u>68</u>	<u>117</u>
(3) Topography: <u> </u> <small>(Hilly) (Flat) (Level)</small>	<u>Deep Tunnel</u>		
(4) Purpose of Well: <u>irrigation</u> <small>(Domestic Irrigation Municipal, Industrial, Other)</small>			

Information upon completion of well:

- (1) Diameter 14 inches.
- (2) Total Depth 117 feet.
- (3) Water Level 21 feet below top of ground.
- (4) Cased to 57, Size 14"
- (5) Screen: Size 14", Length 60
- (6) Were any formations sealed against pollution?
 yes, no.


If YES depth of formation _____

Why _____

Drillers Remarks: _____

2500 g.p.m
surge

CODED

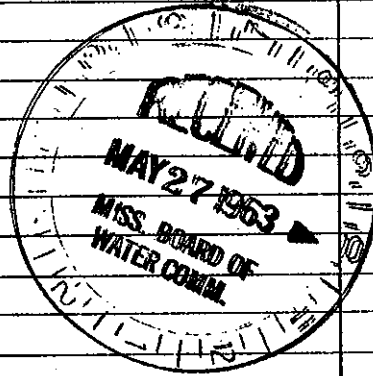

Well No.

(Use Back Side)

Mail this copy to Board of Water Commissioners 429 Miss. St. Jackson, Miss